



COUNTY SURVEYOR
RECORD 2 1869-1900

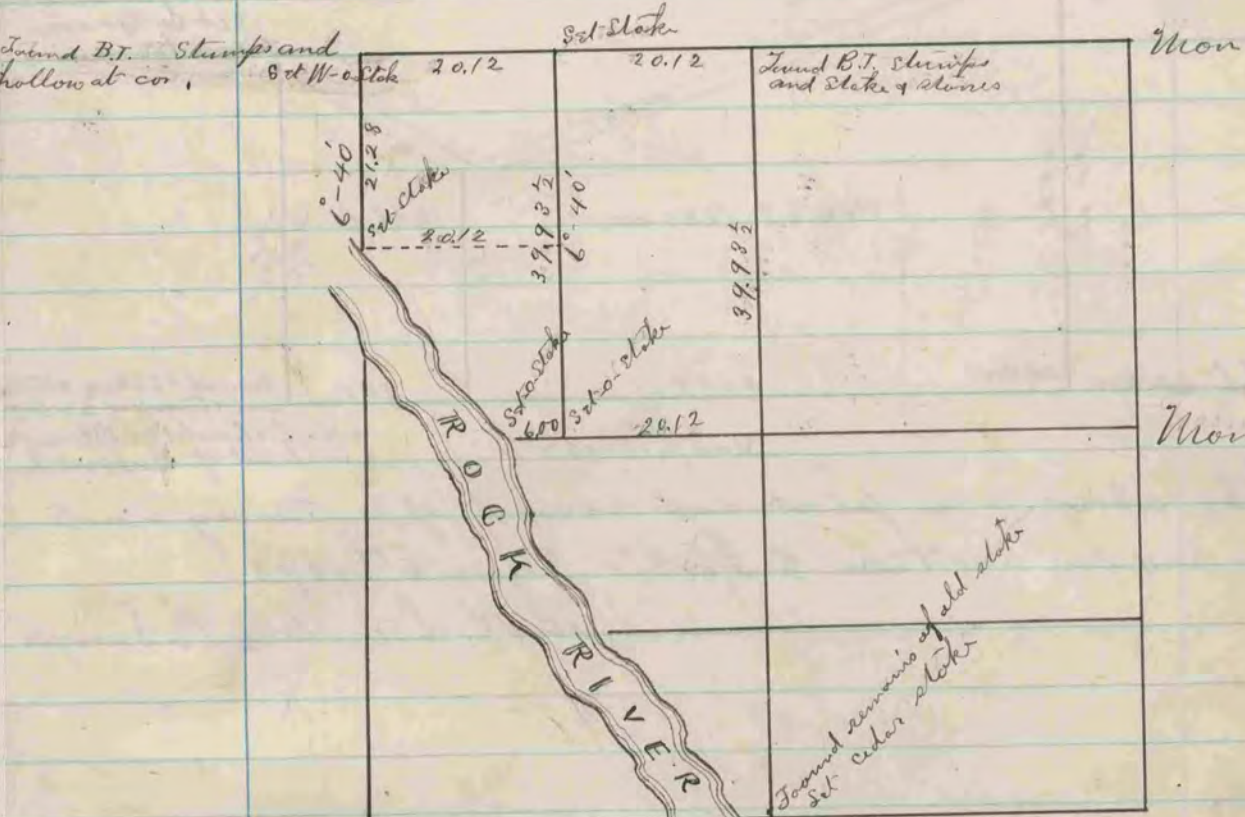

The above is a plat and record of a Survey made by me on Section 36 Rock, May 29th & 30th 1873
R. H. Lee, Dep. Co. Surveyor

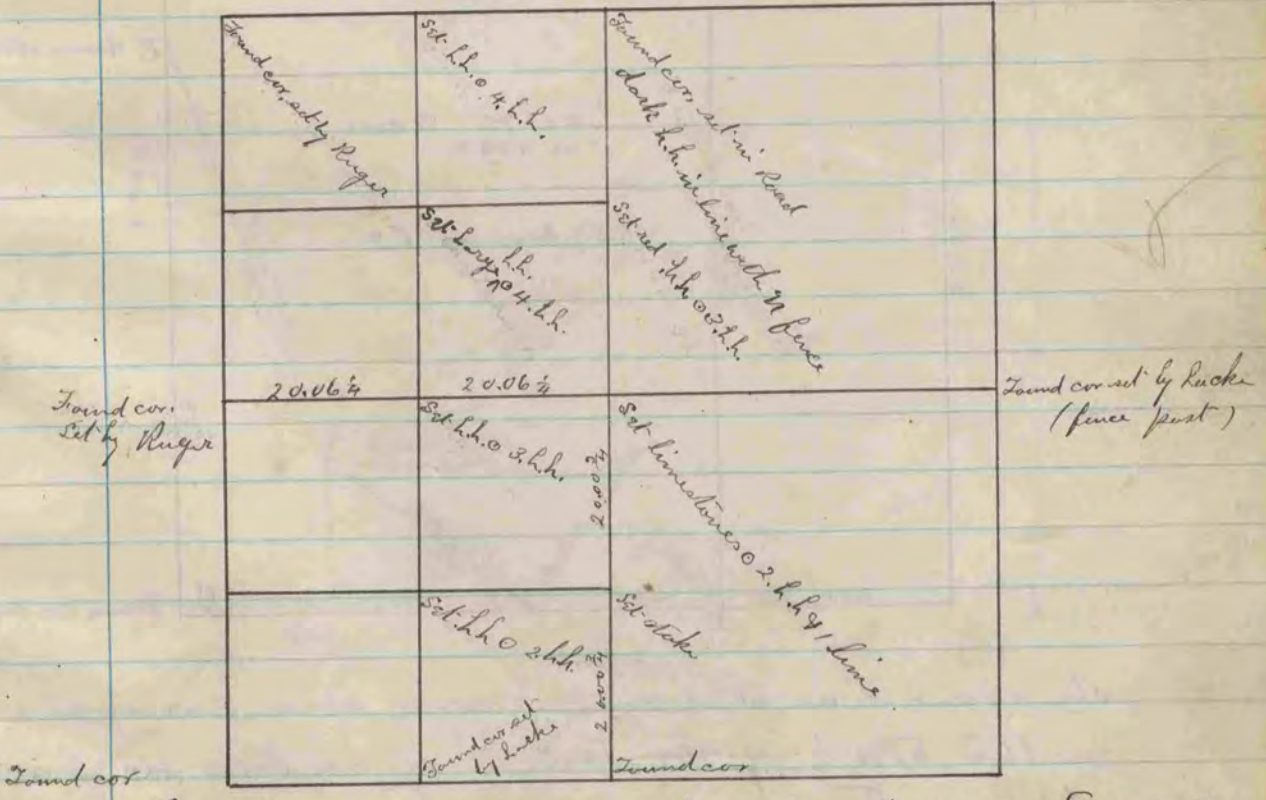

The above is plat and record of a Survey made by me on section 29 Bradford June 3, 4, 1873
R. H. Lee Dep. Co. Surveyor