


41-132

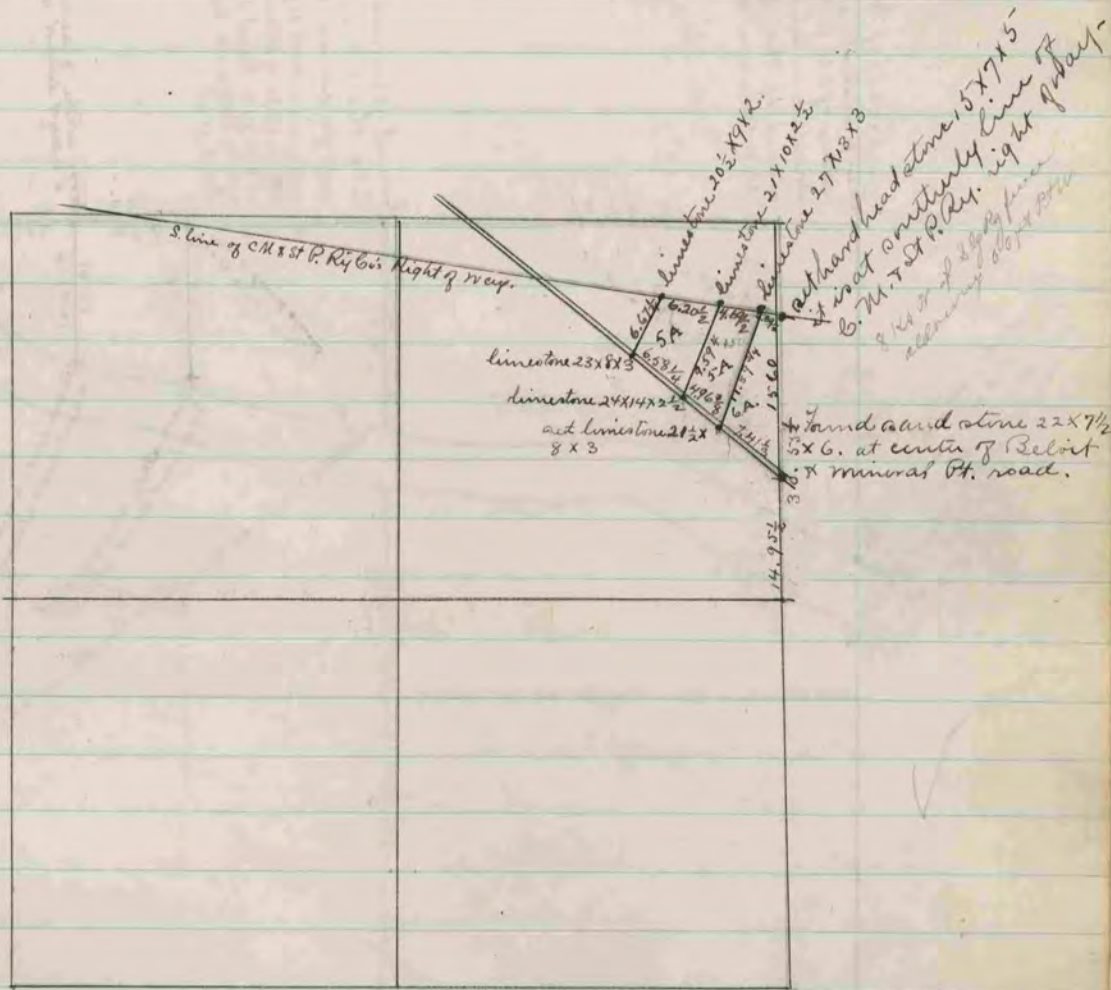

(See page 239.)

The above is a record and plat of a survey made
 by me on sec. 24, Spring Valley, May 21, 1886.
 Edward Rieger
 County Surveyor

COUNTY SURVEYOR
 RECORD 2 1869-1900