


The above is a record and plat of a Survey made by me  
 Sept. 19<sup>th</sup> 1881, on Sec. 20, Clinton, R. K. & E.  
 Co. Surveyor

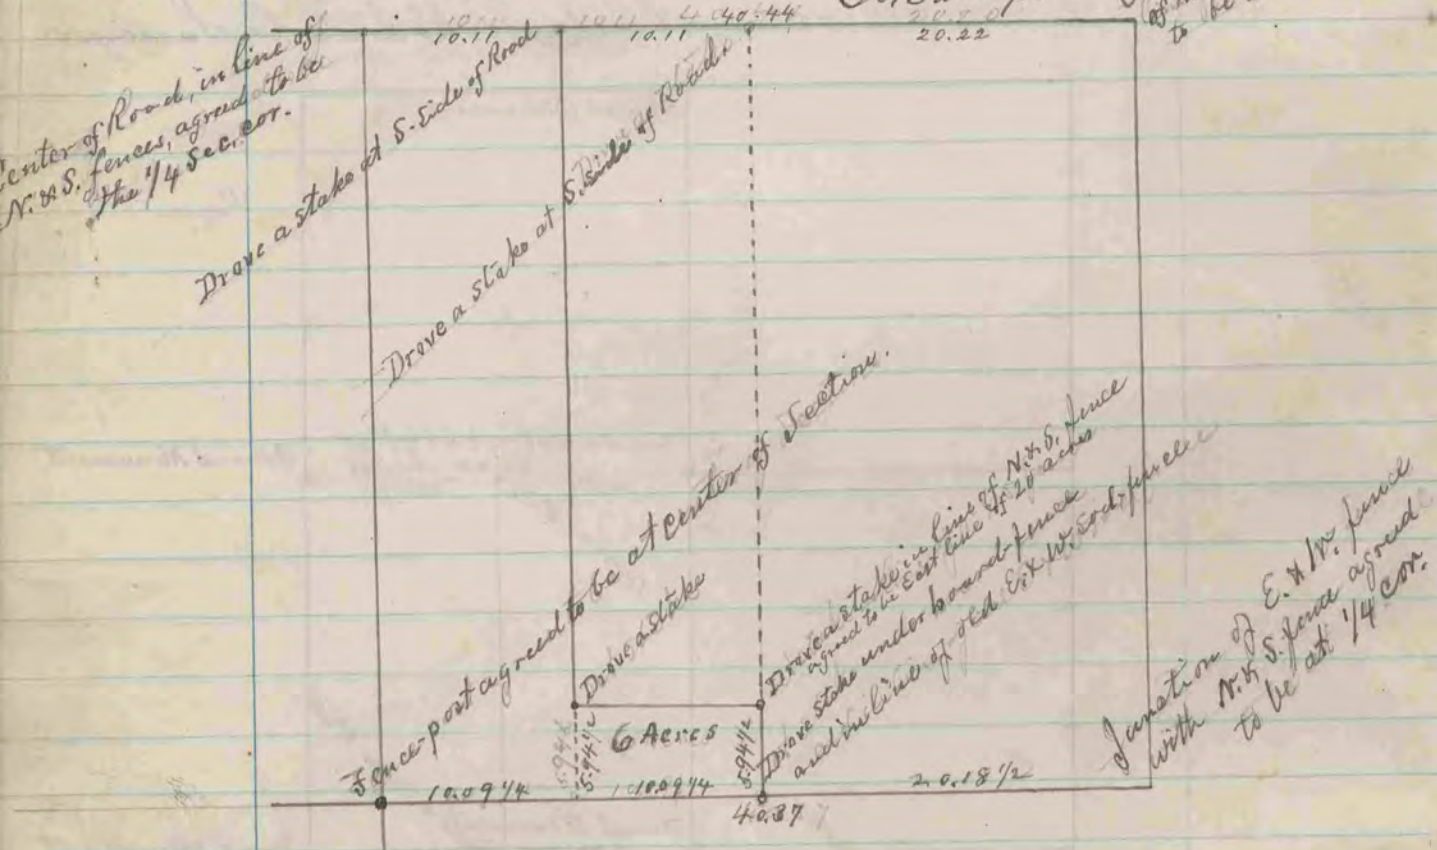

The above is a record and plat of a Survey made  
 by me Sept. 20<sup>th</sup> 1881, on Section 28, Clinton.