


7-132

Found old decayed stake
& where BT stumps had
decayed. Drove new stake
& surrounded by 4 hard
heads & stones.

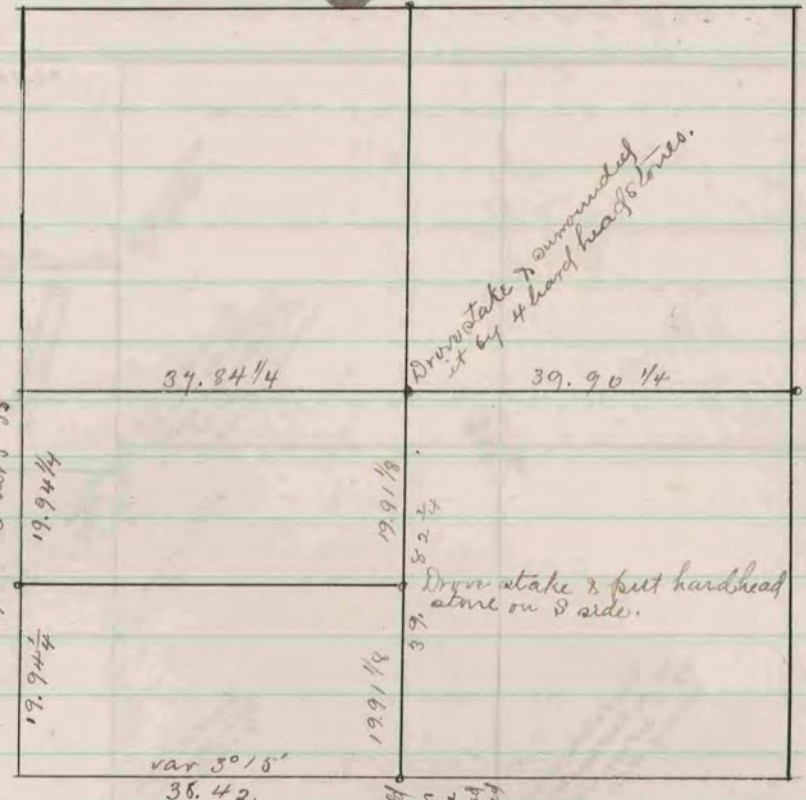

Found old stake & decayed
stump of BT's put a
locust stake in place
of old one.

Drove stake & put hardhead
stone on S side.

Found remains of old
stake & hardhead stone on
S.E. side of S.E. BT & where
stump of N.E. BT had decayed
Drove new stake surrounded
by 3 stumps hard heads.

The above is a record & plat of a survey made by me on
section 7 Johnston, May 3, 1883.

Edward Richey
County Surveyor

recorded on page 288

COUNTY SURVEYOR
RECORD 2 1869-1900