


K. 74

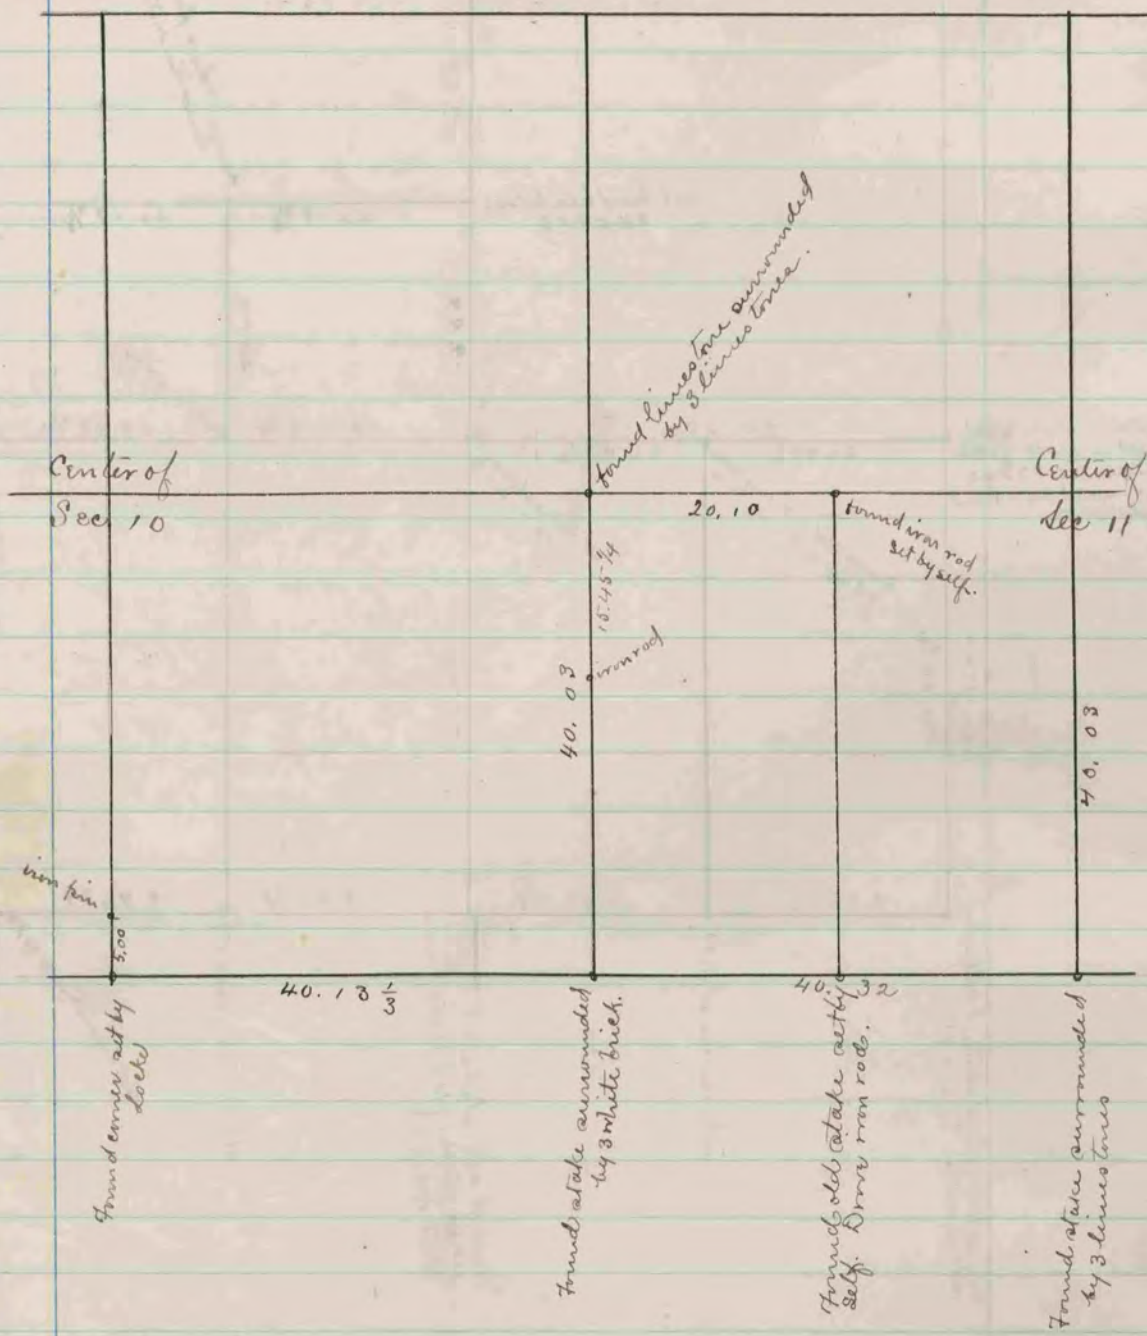

The above is a record & plat of a survey made by me
 on sections 10 & 11 Rock. January 12^{and} 15 1883.

Edward Ruyter
 County Surveyor

COUNTY SURVEYOR
 RECORD 2 1869-1900