


H 9-169

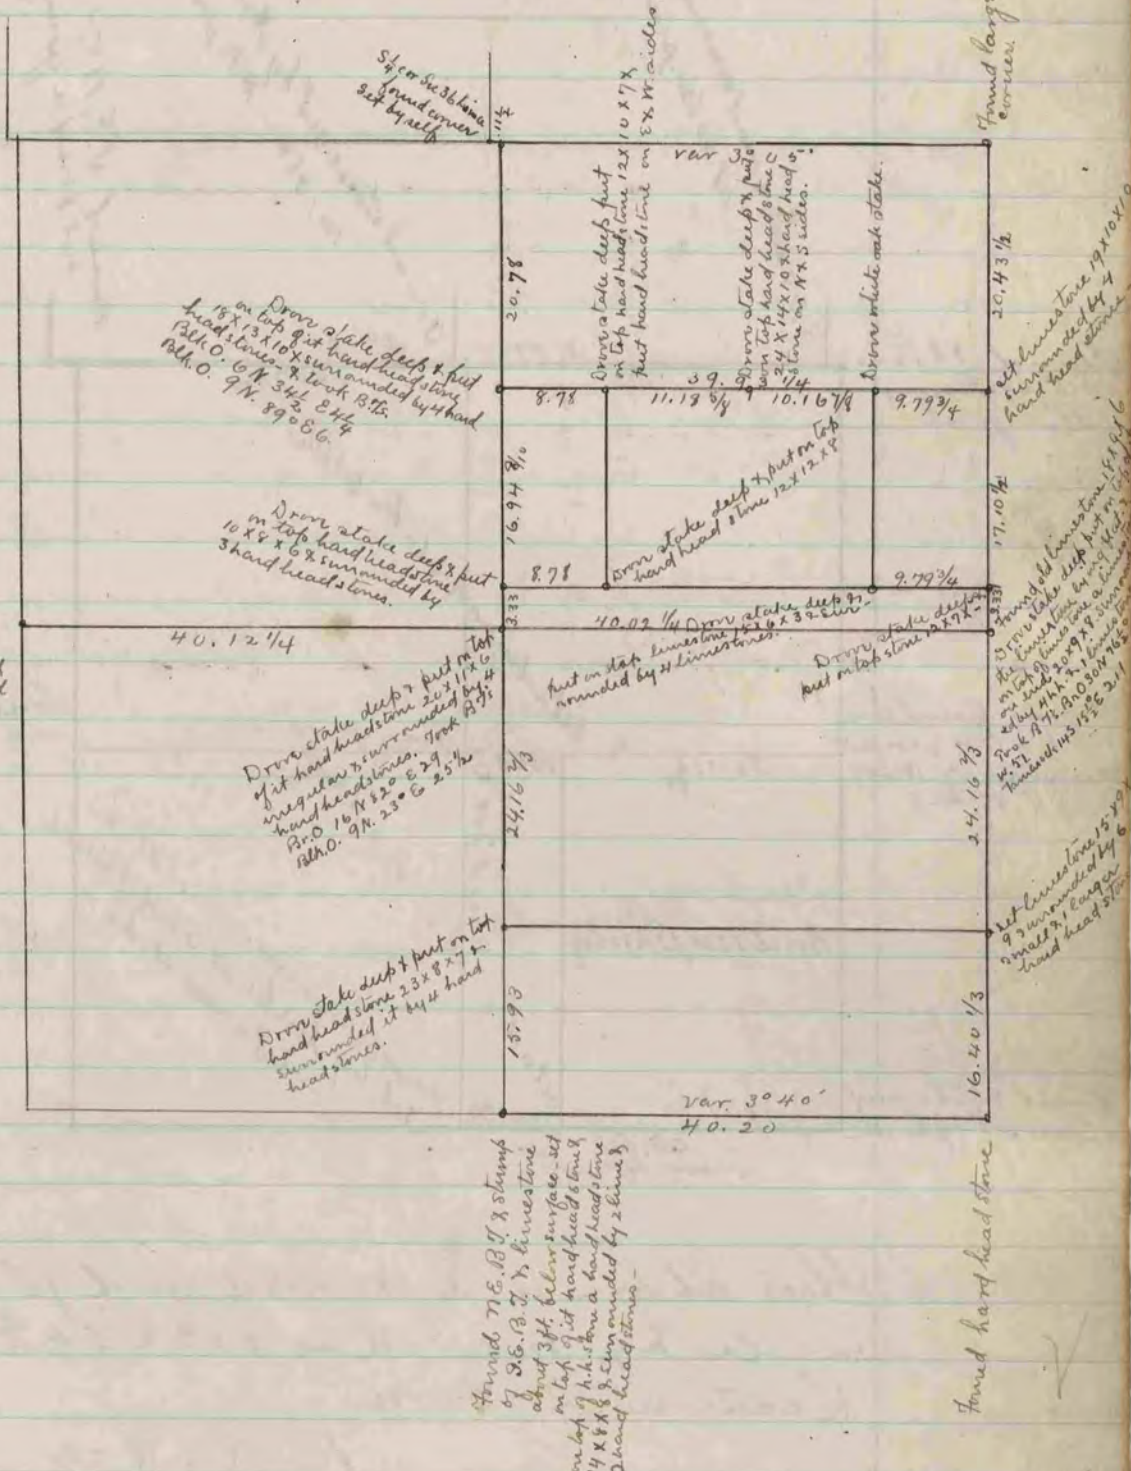

The above is a record & plat of a survey made by  
 me on Section 1 Johnston - December 6 - 1887 -  
 Edward Ruzer  
 County Surveyor

COUNTY SURVEYOR  
 RECORD 2 1869-1900