


The above is a record and plat of a survey made by me on sect 6 Center Twp., 12 & 13, 1900

P. F. Brown  
Co. Surv.

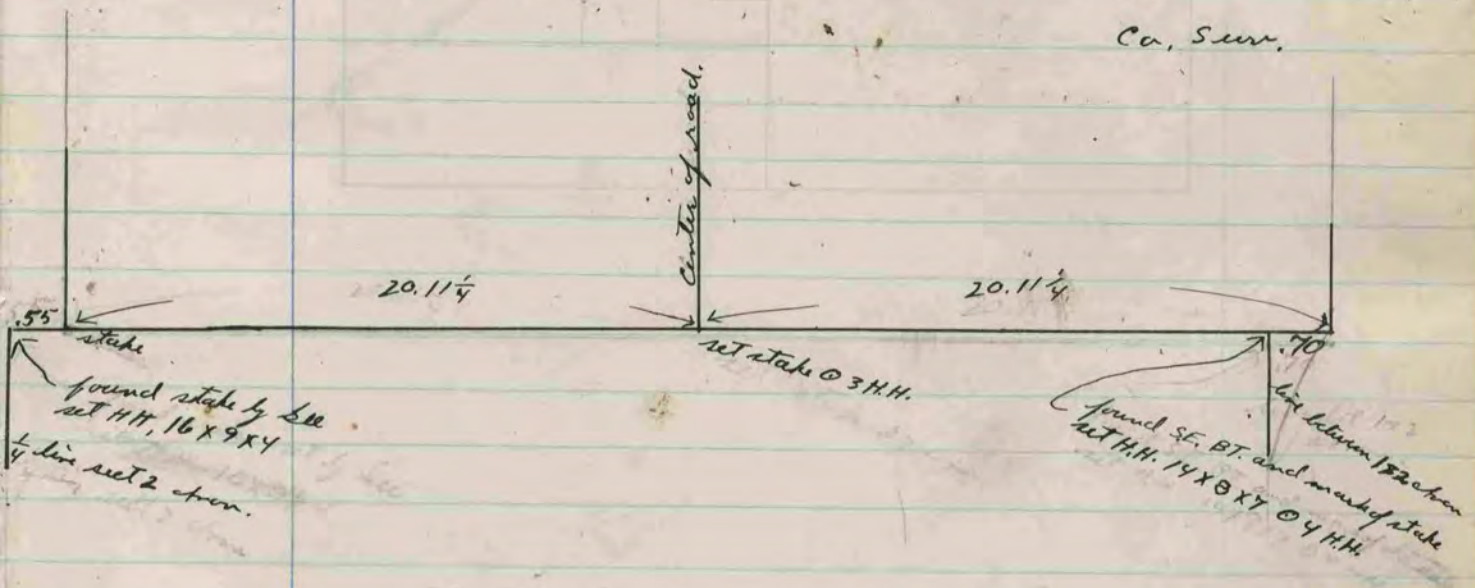

The above is a record and plat of a survey on the south line of the S.E. 1/4 sect 35 Spring Valley, Nov 12, 1900

P. F. Brown  
Co. Surv.

COUNTY SURVEYOR  
RECORD 2 1869-1900