



Taken from note of
O. B. B. Reyer

Found stake Oct. 6, 1917
Set new stake.

Set iron rod.

Set stake
8 1/4 H.H.

Sec. 35
Iron.

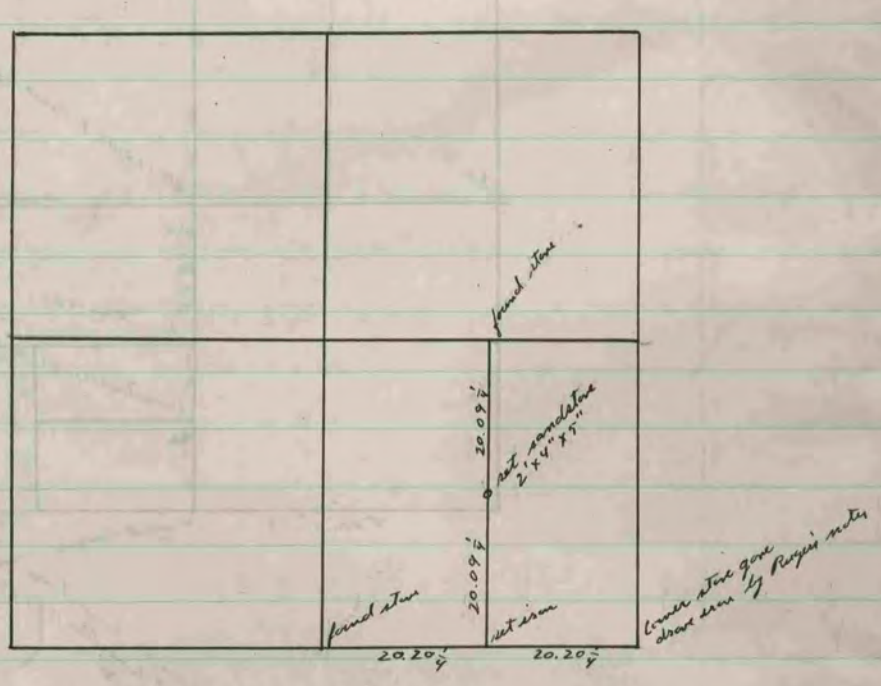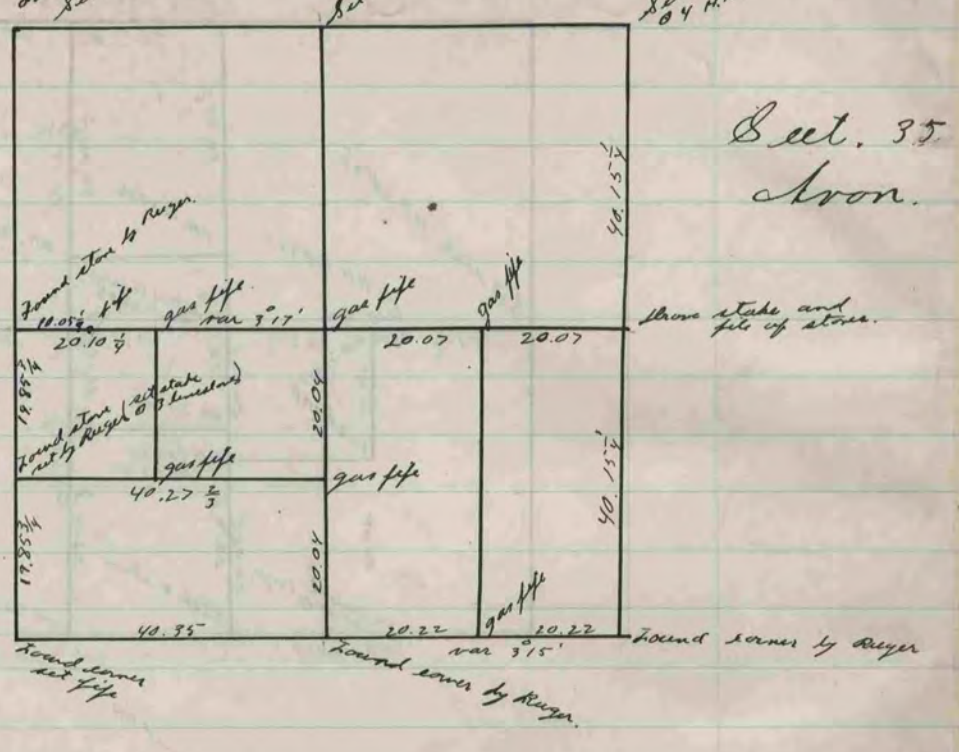

The above is a record and a plat of a survey made by me on Sect. 8, Fulton on Dec. 10, 1898

Perry F. Brown
County Surveyor

COUNTY SURVEYOR
RECORD 2 1869-1900