


The above is a plat and record of a Survey made by me on Section 1 Janesville June 18th 1872.

R. K. Lee, Dep. Co. Surveyor

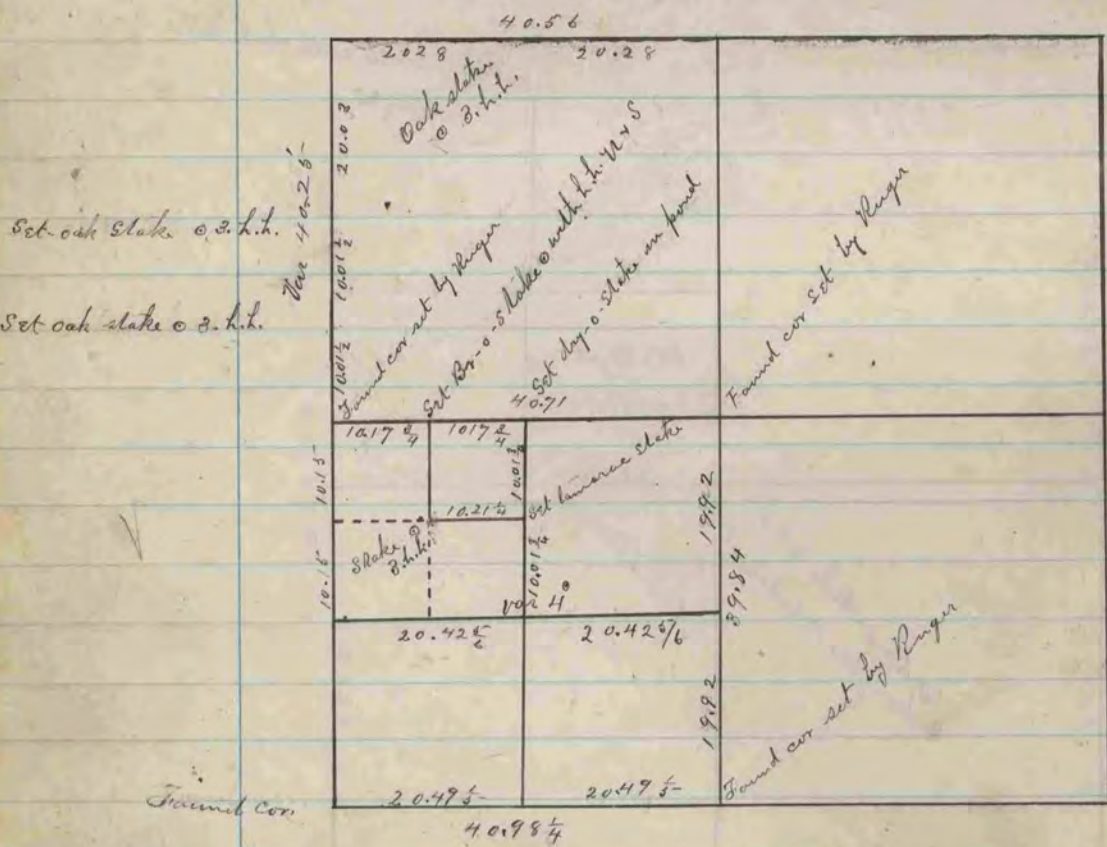

The above is a plat and record of a survey made by me on Section 22 Linn April 23rd 1872

R. K. Lee, Dep. Co. Surveyor