


Drive stake

See page 121

Stone Monument

Drive stake

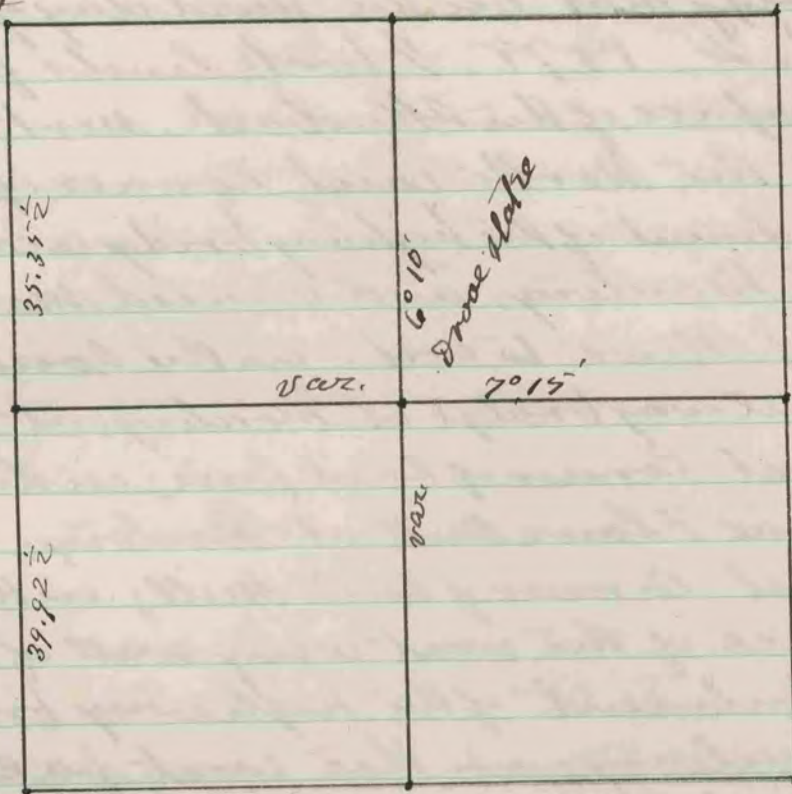

See page 141

For corners on south line
See page 172

The above is a record and plat
of a survey made by me on
Section 6 Carter Sept 29-1876
Edward Rugg
County Surveyor