


The above is a record & plat of a survey made by me on section 21 Fulton May 12 & 13, 1893

O. J. Bledorn
County Surveyor

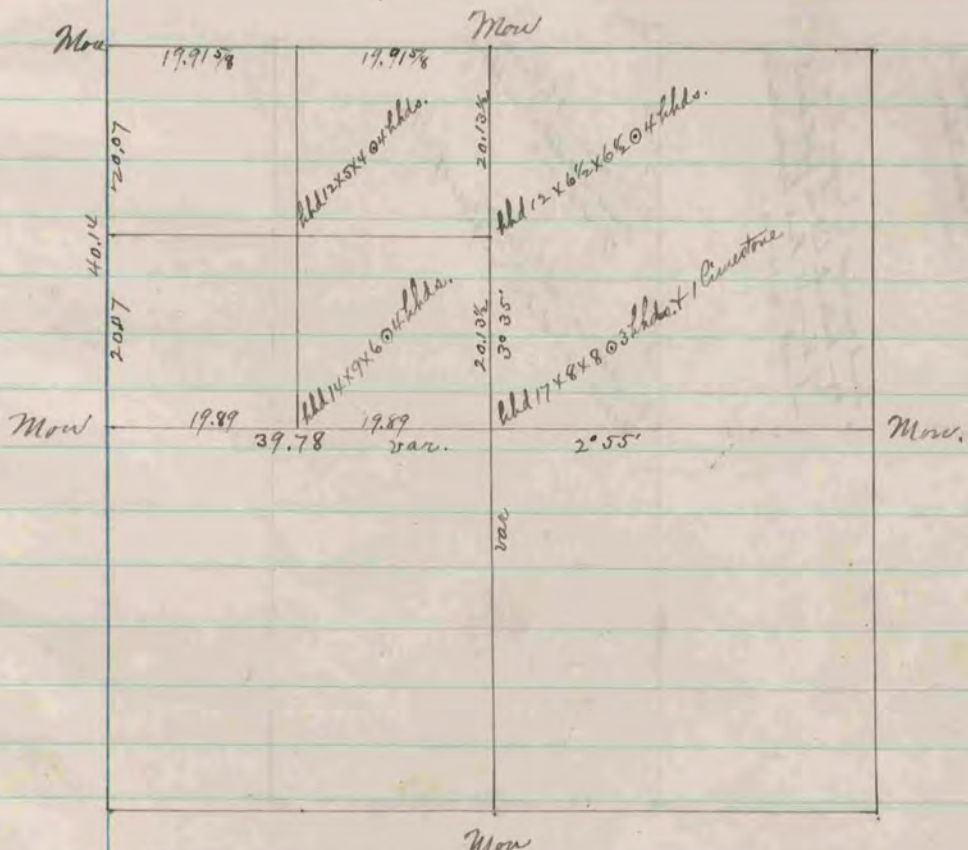

The above is a record & plat of a survey made by me on section 17 Milton June 7, 1893

O. J. Bledorn
County Surveyor