


The above is a record & plat of a survey made by me on section 11 Rock Jan 7, 1894
 O. G. Bleedorn,
 County Surveyor

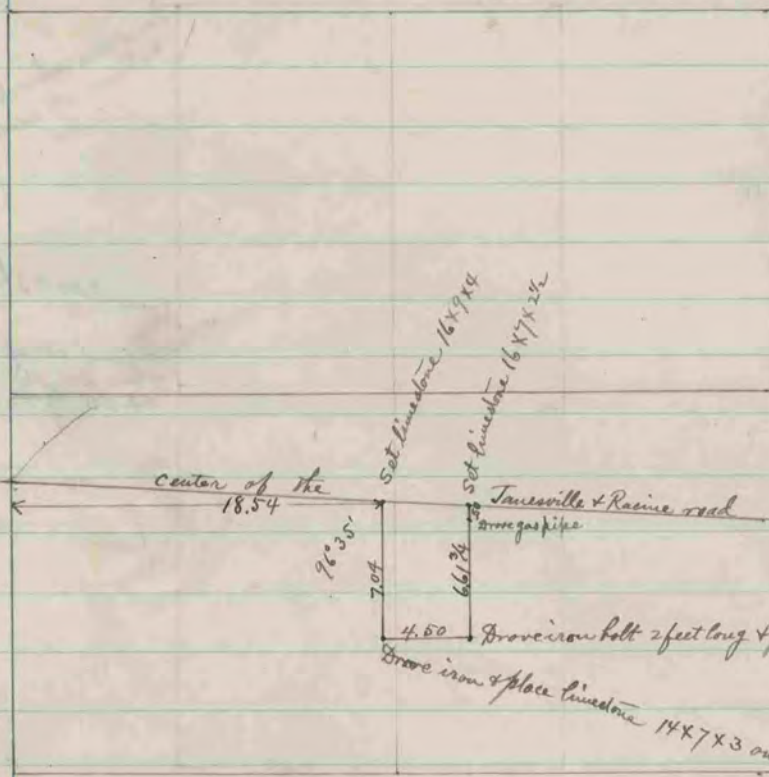

The above is a record & plat of a survey made by me on the SW 1/4 of section 6 Bradford March 12, 1894

O. G. Bleedorn
 County Surveyor