

Record of a survey made for Dr Seals Mr Houseman and others on section ten in the Town of Beloit on the 26 & 27 days of March A.D 1837

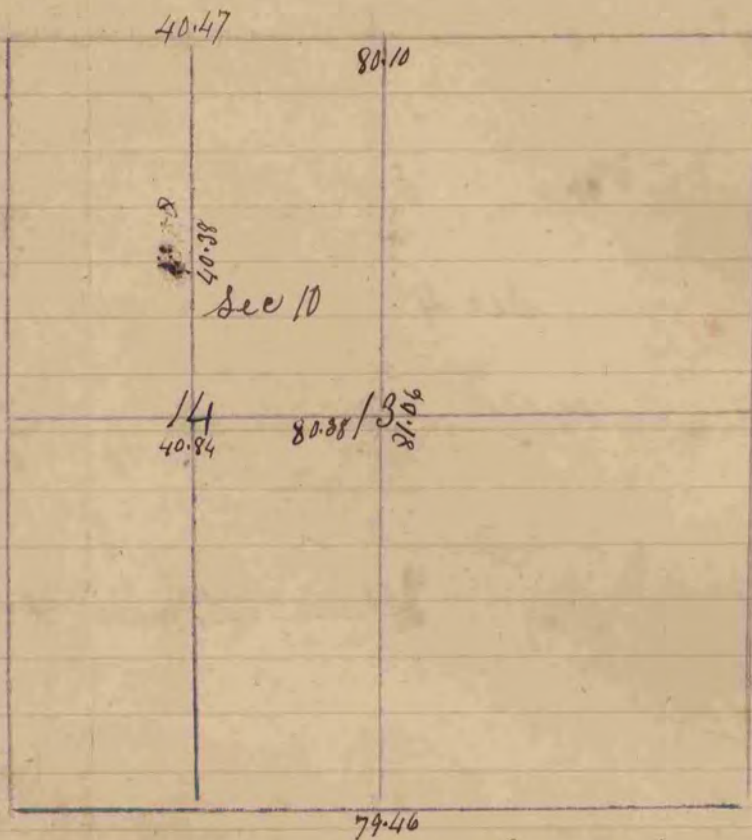


Figure 13 represents the centre of the section
White Oak 18. S 10 1/4 W 2.19 Mr other

Figure 14 W. 0 16. S. 9 1/2 E. 18 Also W. 0 24. N 50 W. 64

Peter McLean County Surveyor

COUNTY SURVEYOR
RECORD 1 1851-1869