


Found old stakes in
both bearings
line on 16/12/1872
var. 50 20'

Set out brick
face 30' and
found hat in
found

cedar stake set by Doelle

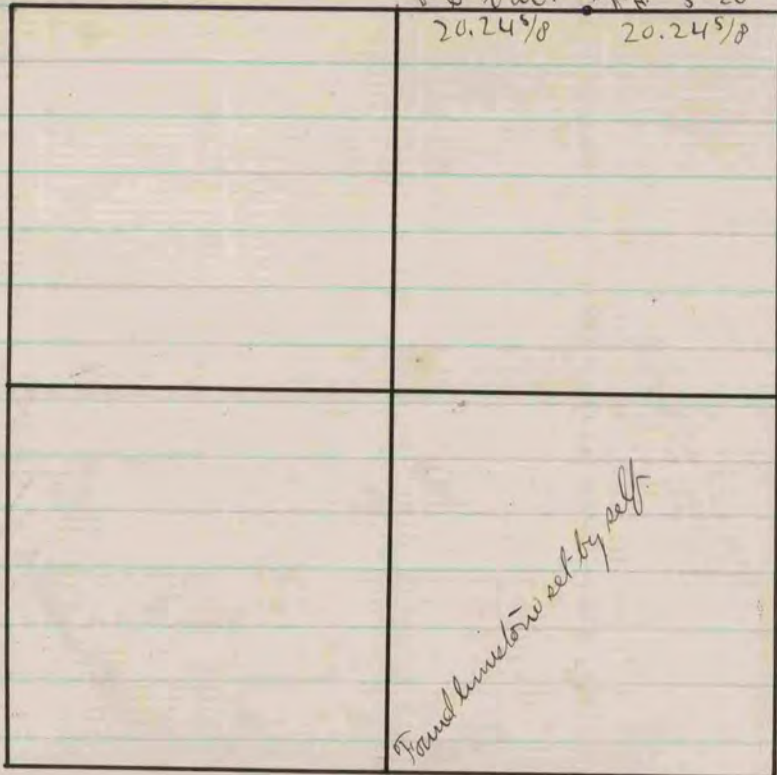

Found old stakes


The above is a plat & record of a survey made by me May 16. 1870. on
Sec. 25 Janesville

Edward Ruger Supt. Co. Surveyor.

Stone mon. set by
Doelle

Stone mon. set by Doelle

Stone mon. set by Doelle

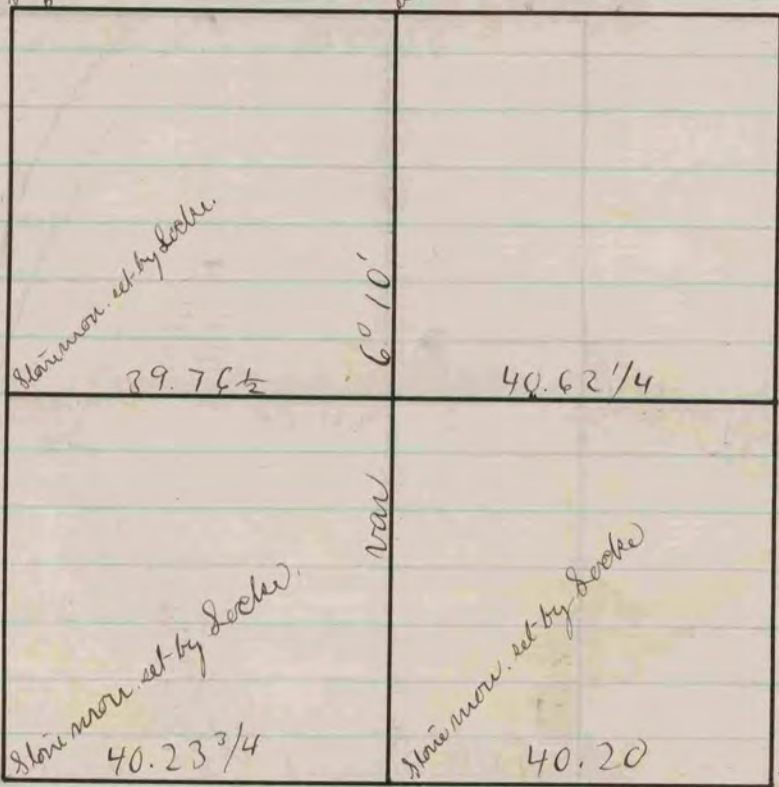

The above is a plat & record of a survey made by me
June 11. 1870. on Sec. 13. Plymouth

Edward Ruger
Supt. Co. Surveyor

COUNTY SURVEYOR
RECORD 1859-1906