


The above is a plot and record of a survey made by me, Dec. 3. 1870. on Sec. 23 above Edward Ruger.

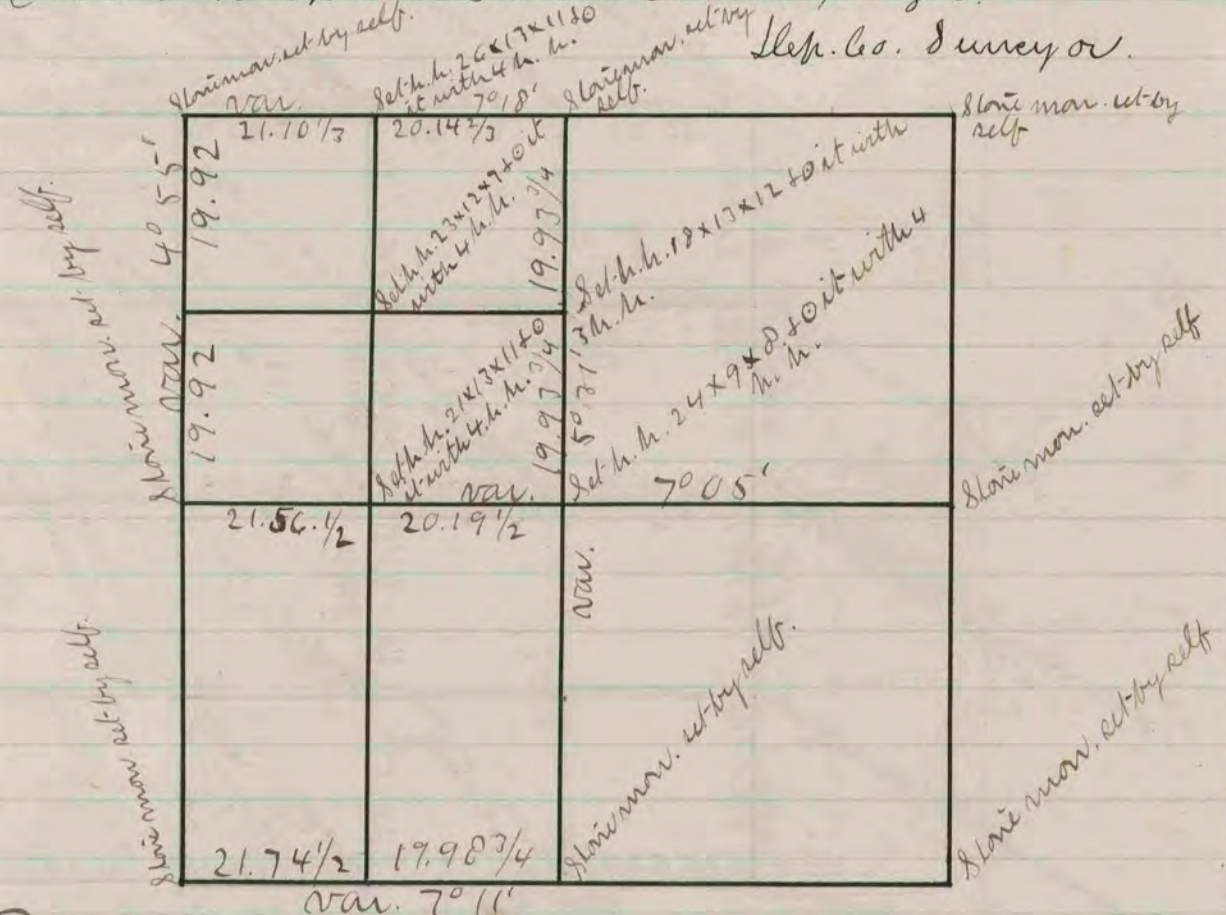

Plat and record of a survey made by me, Dec. 20, 21 & 22, 1870 on Sec. 7 Union Edward Ruger Dep. Co. Surveyor

RECORD 1859-1906

COUNTY SURVEYOR RECORD 1859-1906