

Record of a survey made for Mr. Seals, Mr. Houseman  
and others, on Sec. 10, Beloit, on the 26<sup>th</sup> & 27<sup>th</sup> March  
1851

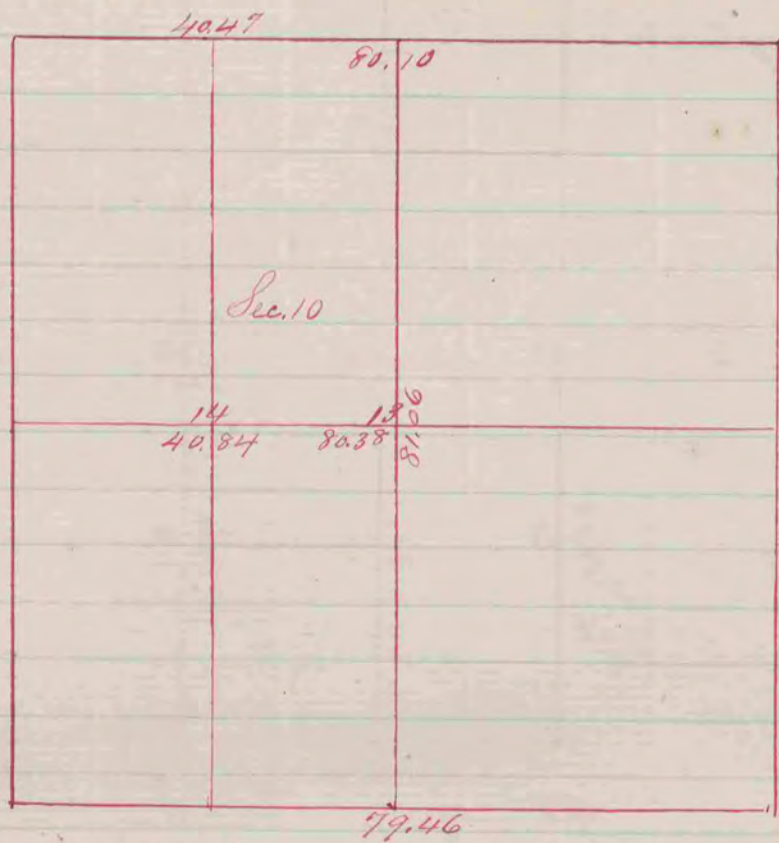


Fig. 13 represents the centre of the Sec.  
White oak 18. S 10 $\frac{1}{4}$  W 2. 19 no other  
Fig. 14 N. O. 16. S. 9 $\frac{1}{2}$  E. 18. Also N. O. 24. N. 50 W. 64  
Peter McBeau Co. Surveyor

(Recorded in Vol I page 2)