


A Record & Plat of a Survey made on Sec. 21, T. 1, R. 12 for
Hester Farr & Dessen by Edward Rizer Co. Surveyor
Rock Co.

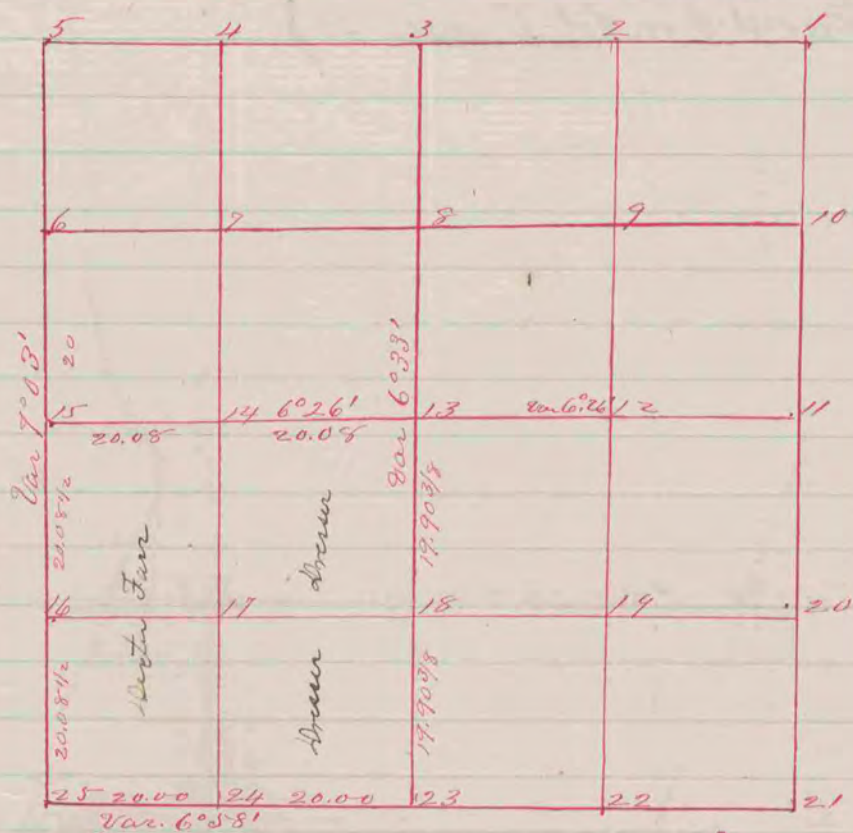

(Recorded in Vol I page 96)

- At Fig. 3 surrounded 1/4 post by 4 hard head stones
- " " 11 " " " " " " " "
- " " 13 " " " " " " " "
- " " 14 " 1/8 " " " " " "
- " " 15 " 1/4 " " " " " "
- " " 16 " 1/8 " " 3 " " "
- " " " Burr Oak 2 S 7° 03' W 54 1/2
- " " " " 8 N 2° 18' W 144 4/3
- " " 17 Surrounded 1/16 post by 3 hard head stones
- " " 18 " 1/8 " " 4 " " "
- " " 23 " 1/4 " " " " " "
- " " 24 " 1/8 " " " " " "
- " " 25 " Sec cor " " Line Stones
- " " " Look New Witness trees
- " " " Burr Oak 10° S 35° 50' E 196
- " " " Black " 5 S 50° 48' W 155 1/3
- " " " Hickory 2 N 64° 31' W 171 1/3