


The above is a plot and record of a survey made by me,
Nov. 9 + 10. 1870. on Sec. 6 Rock

Edward Ruger

Dep. Co. Surveyor

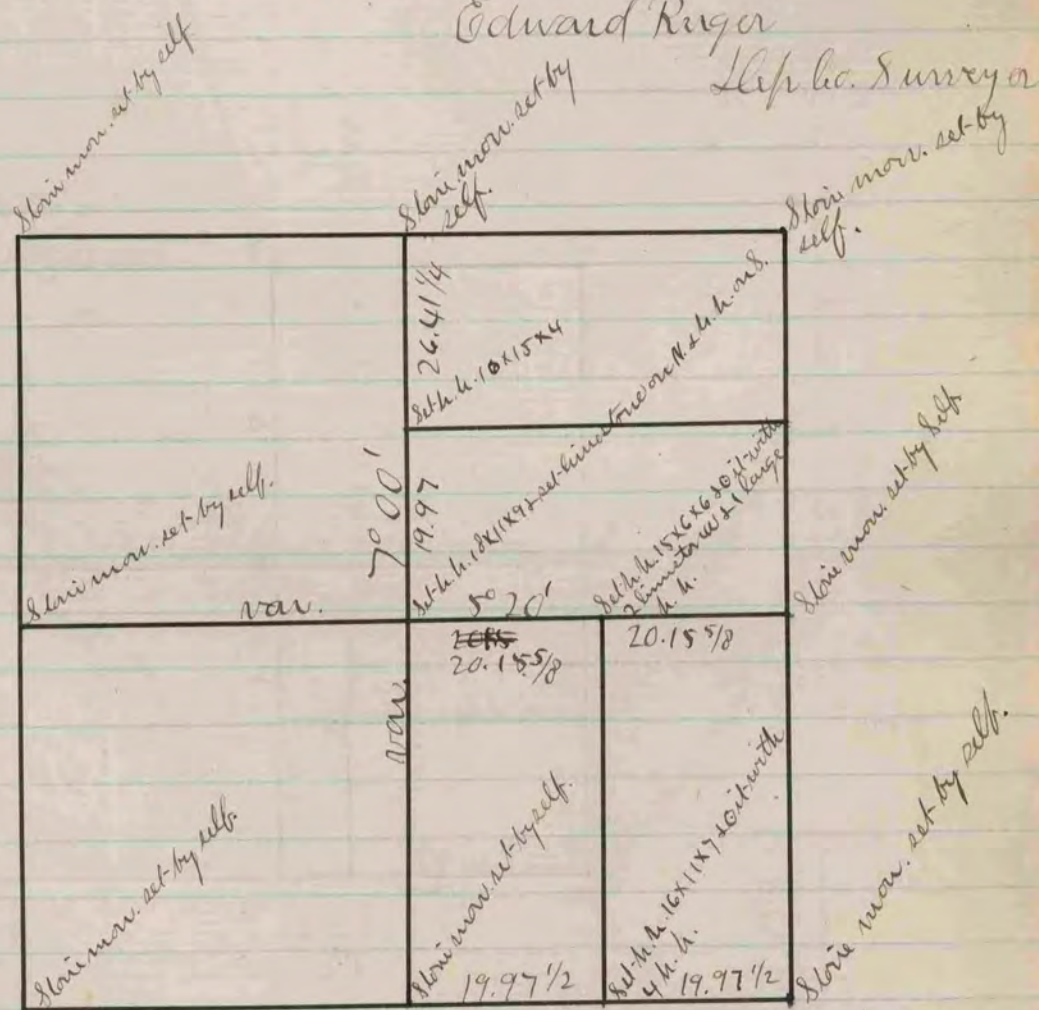

The above is a plot and record of a survey made by me
Nov. 16. 1870. on Sec. 4. Harmony

Edward Ruger

Dep. Co. Surveyor