


The above is a record and plat of a survey made by me Oct. 15th 1880 on Section 14 Rock.

R. K. Lee, Deputy Co. Sur.

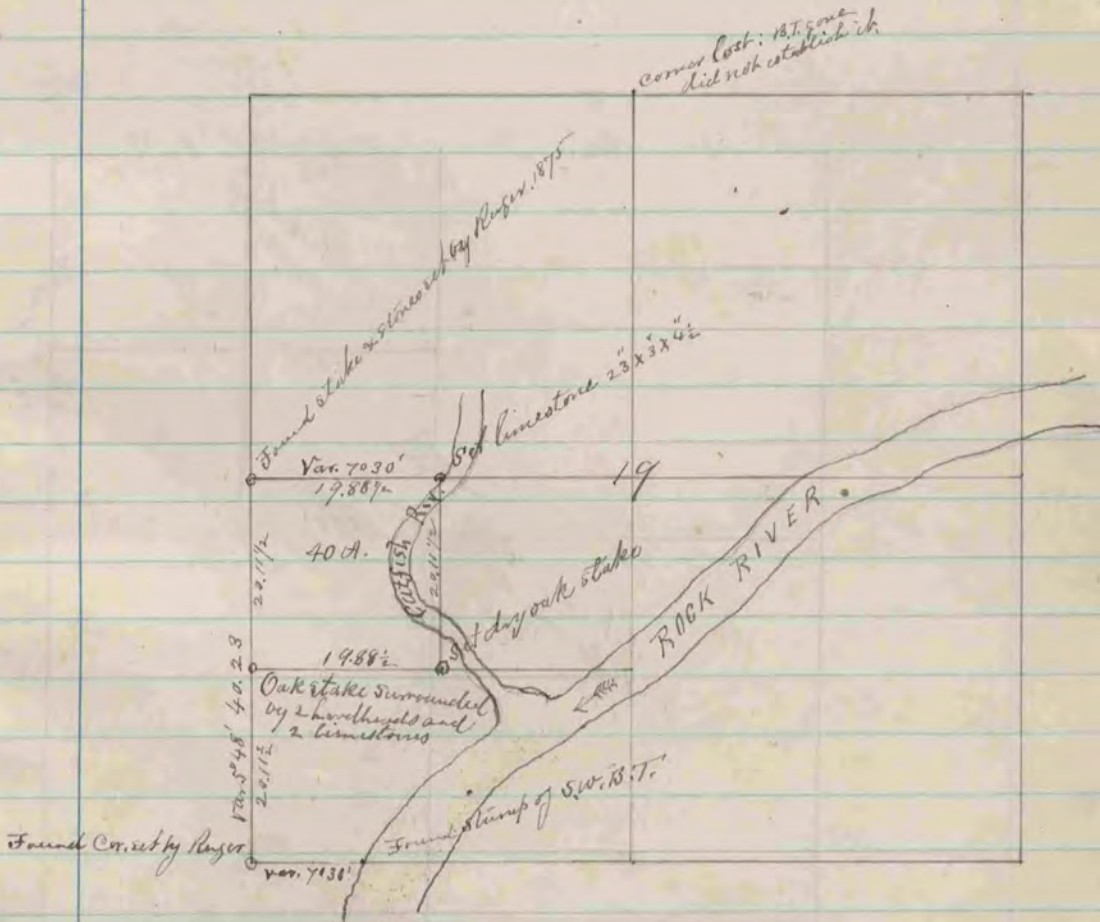

The above is a record and plat of a survey made by Oct. 20th and 21st 1880 on Section 19, Fulton.

R. K. Lee

Deputy Co. Surveyor