


The above is a record and plat of a survey made by me Sept. 30th 1880, on Section 29, Milton.
 R. K. Lee Dept. Co. Sur.

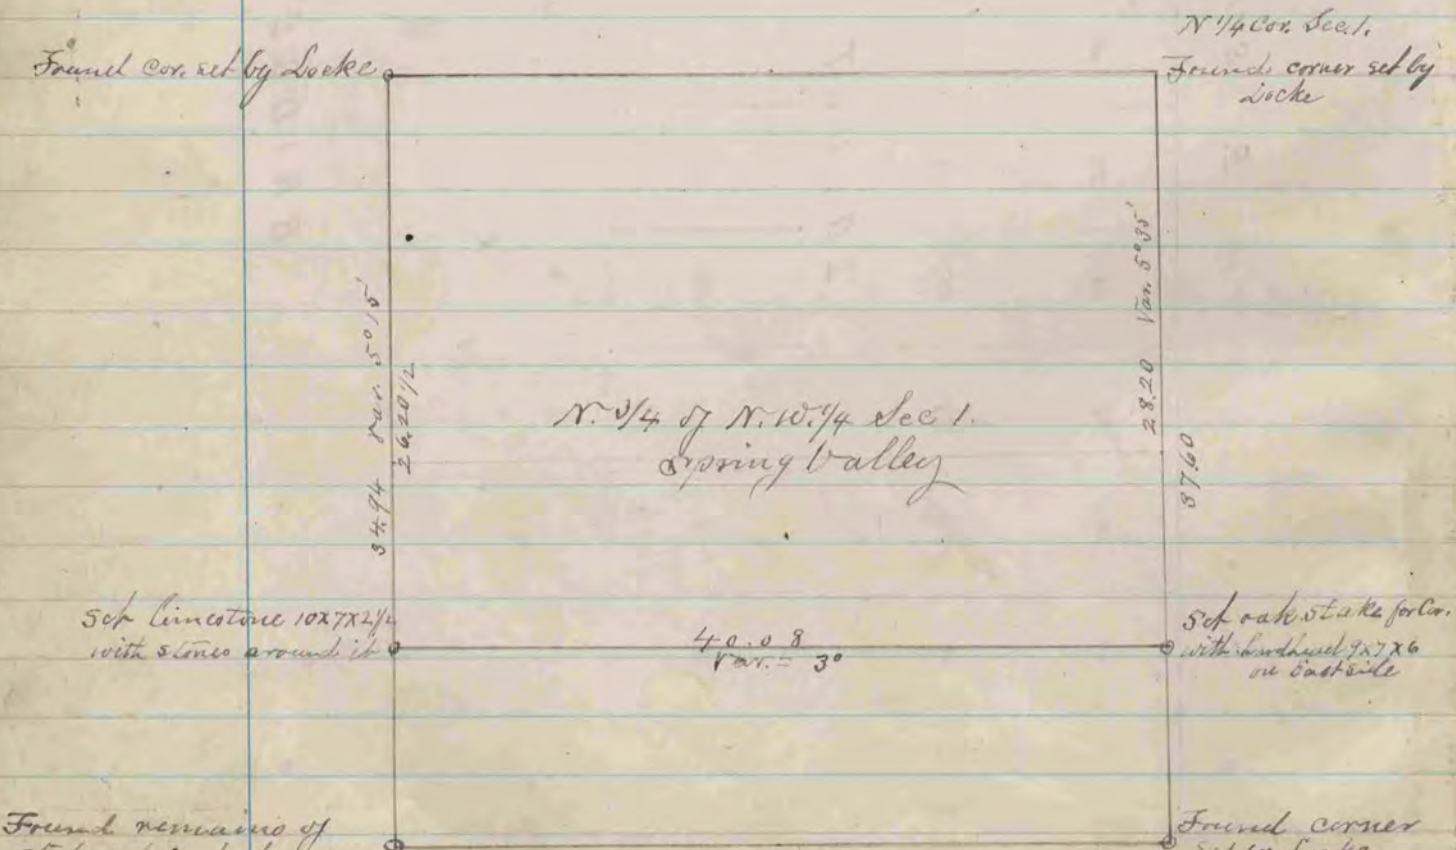

The above is a record and plat of a survey made by me Oct. 14th 1880, on Sec. 1, Spring Valley, R. K. Lee Dept. Co. Sur.