


The above is a record and plat of a survey made by me Sept. 5th & 6th, 1881, on Section 6, Beloit.
R. K. Lee, Co. Surveyor.

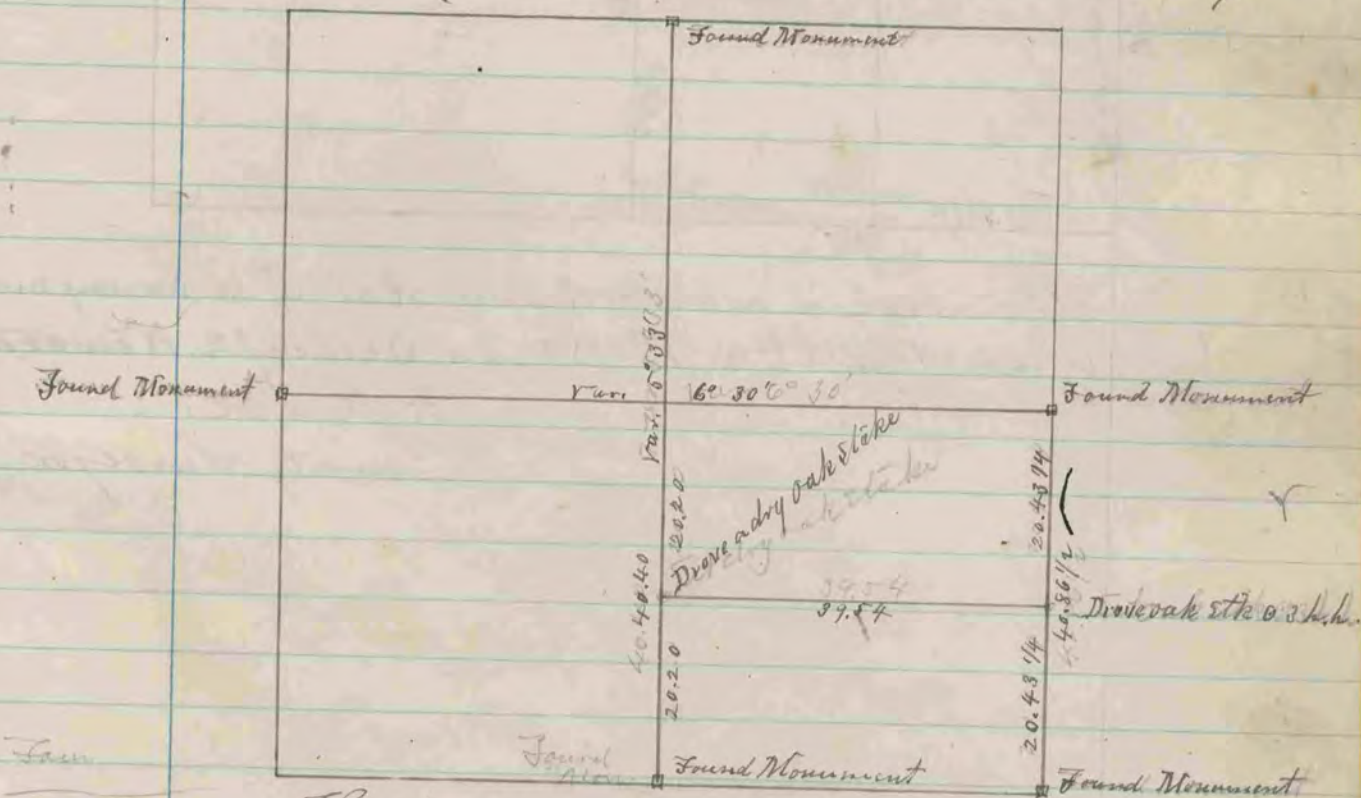

The above is a record and plat of a survey made by me Sept. 7th, 1881, on Section 14, Newark.
R. K. Lee,
Co. Surveyor.