


COUNTY SURVEYOR
RECORD 2 1869-1900

Found corner established by
Lodge - Census corner

Found slatke and surrounded
it with six small stones -

Found remains of old slatke also
found where slatke of B. G.
had been dug up - Found
large brown oak slatke in the
place of old slatke and
surrounded it with seven
stones

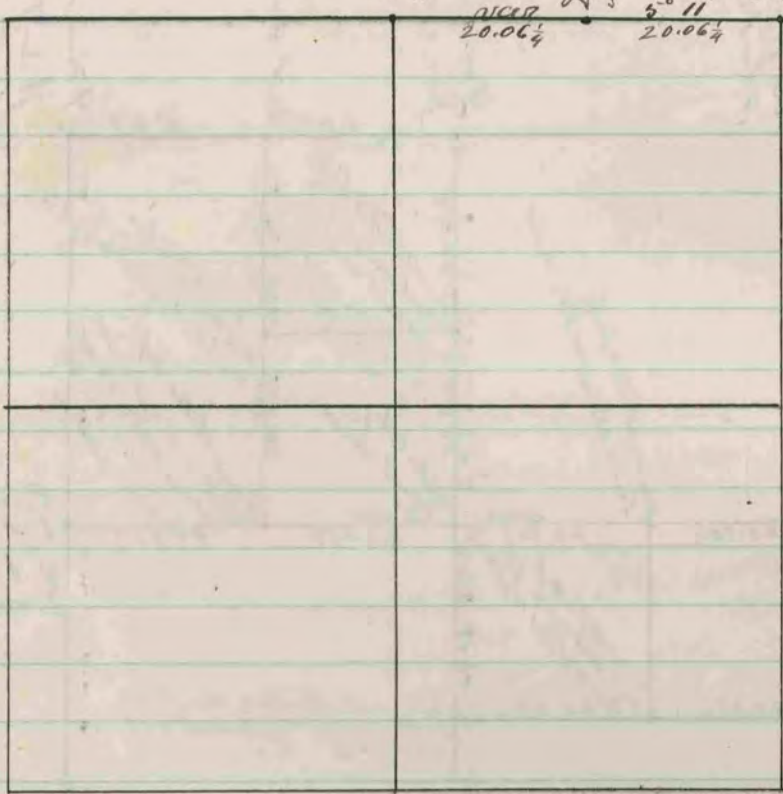

The above is a record and
plot of a survey made by me on section
11 town June 25. 1974
Edward Rieger
County Surveyor

COUNTY SURVEYOR
RECORD 2 1869-1900