


RECORD 2 1869-1900
COUNTY SURVEYOR


at 4000 found cor.
set by Graves of Lane Co.

At 2000 found cor.
set by Graves.

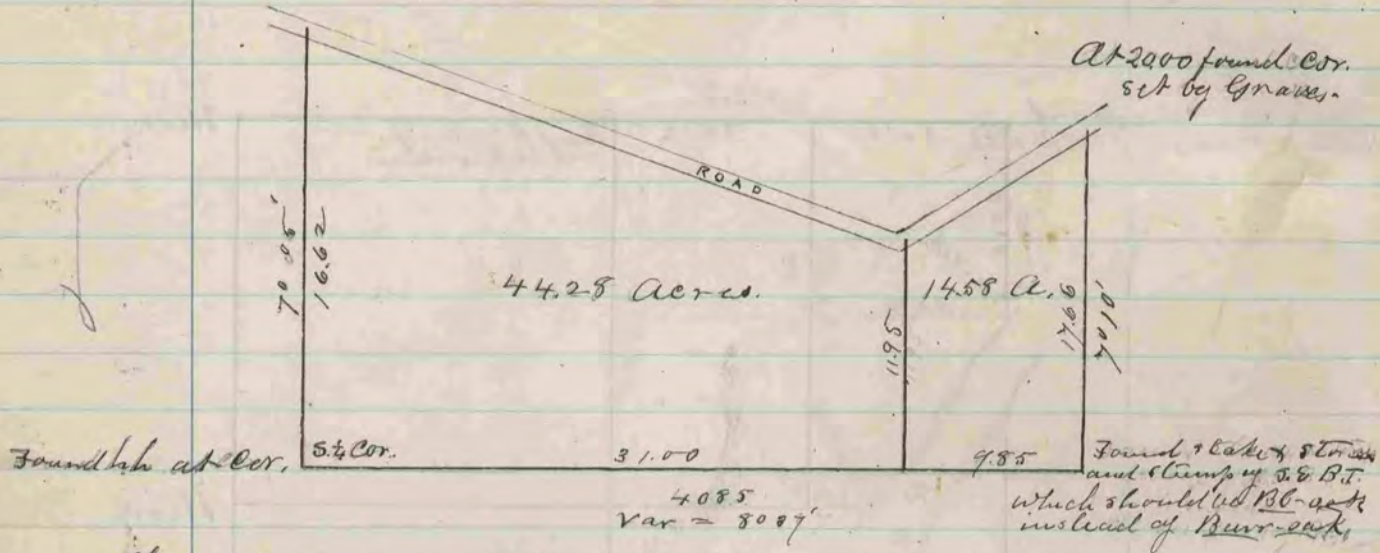

The above is a plat and record of a Survey made by me on section 5 Porter June 6th 1873.

R. H. Lee, Dep. Co. Surveyor

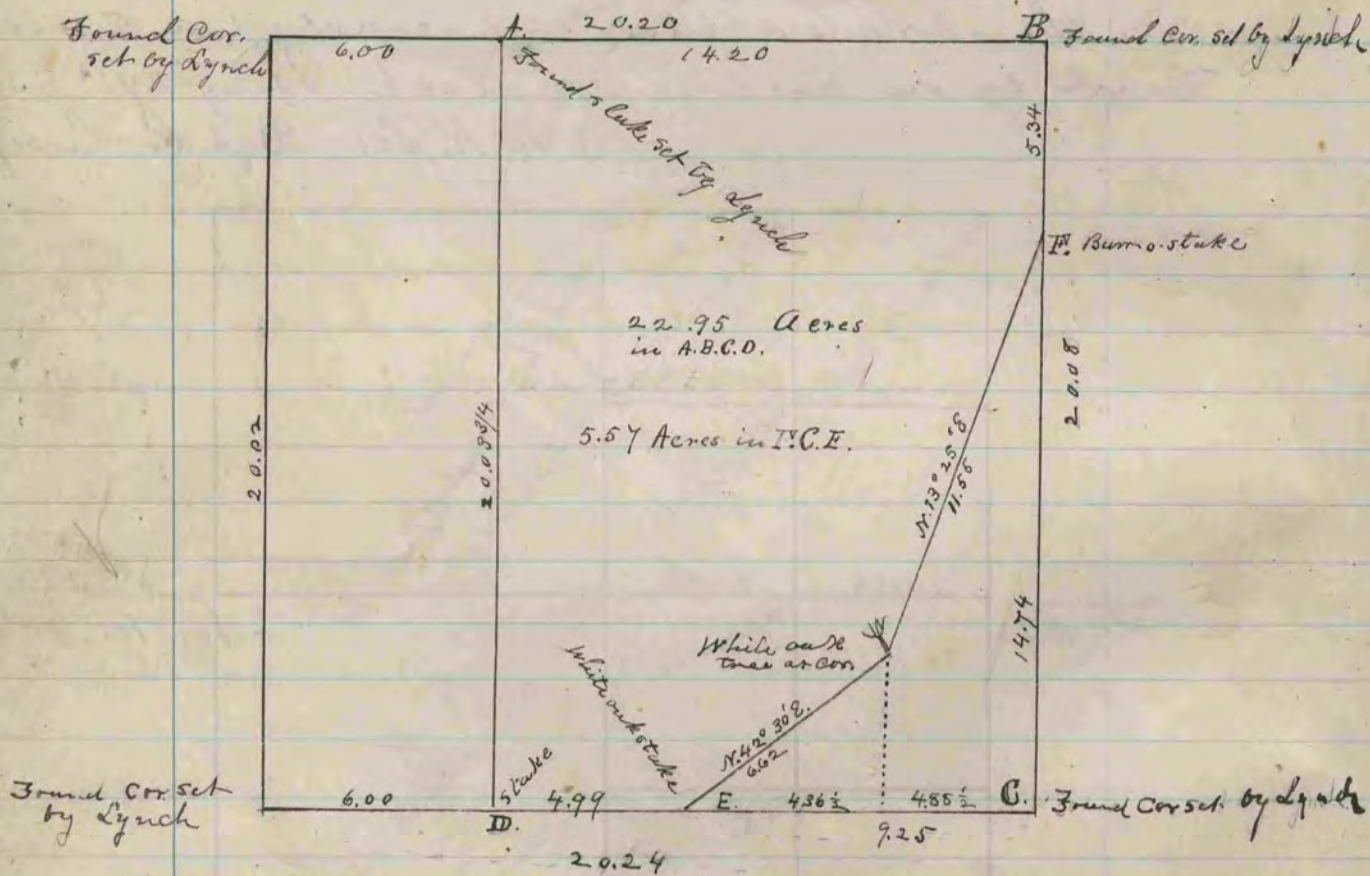

The above is a plat and record of a Survey made by me on the S.W. 1/4 of the N.E. 1/4 of section 14 Janesville June 9th 1873.

R. H. Lee

Dep. Co. Surveyor

COUNTY SURVEYOR
RECORD 2 1869-1900