



See Section 2 Clinton Page 45

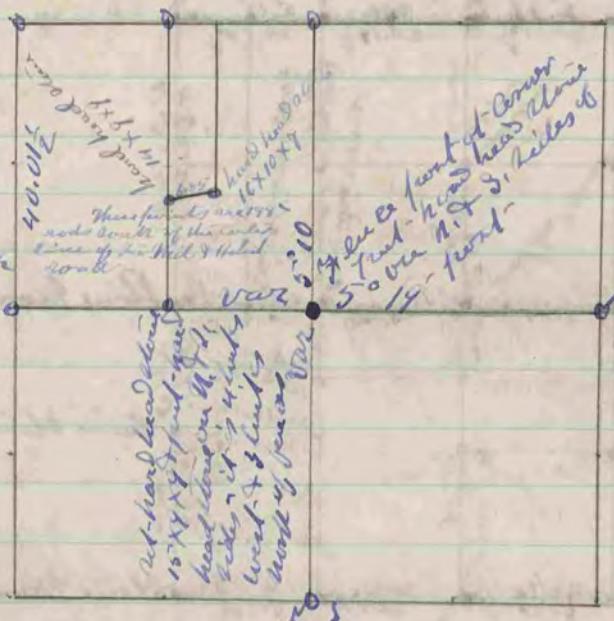

The above is a plot and record of a survey made by me on Section 2 Clinton Oct. 13-1871

Edward Puffer
County Surveyor

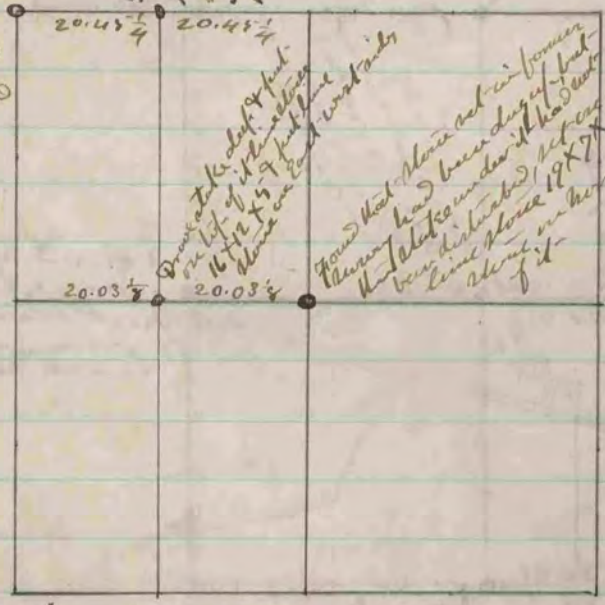

See Section 12 Porter Page 39

The above is a record and plot of a survey made by me on Section 12 Porter, Nov. 8 & 9 1871

Edward Puffer
County Surveyor