


A Record and Plat of a Survey made on Sec 21 T1 R12
for Dexter Garr & Dreyer by Edward Ruger County Surveyor
of Rock County of Wis - Distances given in chains,
Variations marked on the lines.

Beloit

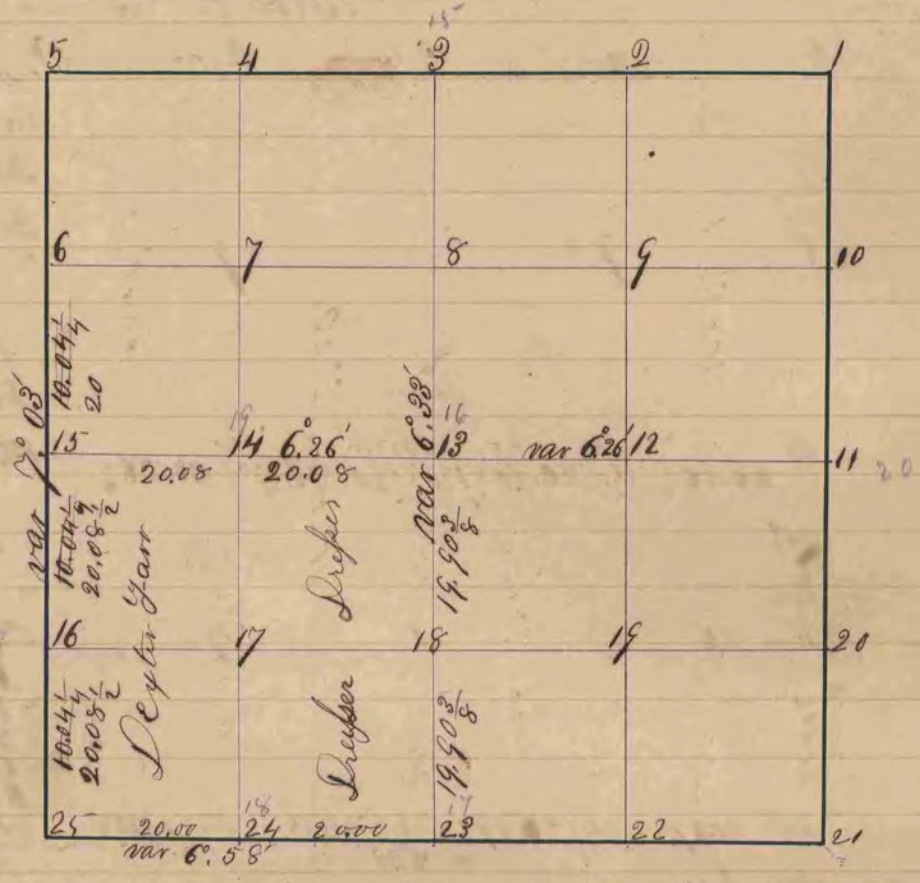

- At Fig 3 Surrounded 14 post by 4 Hard Head Stones
- " " 11 " " " " " " " "
- " " 13 " " " " " " " "
- " " 14 " 1/8 " " " " " "
- " " 15 " 1/4 " " " " " "
- " " 16 " 1/8 " " 3 " " "
- " " " Burr Oak 2 S 7° 03' W 54 1/2
- " " " " 8 N 2° 18' W 144 1/2 var 9° 03'
- " " 17 Surrounded 16 post by 3 Hard Head Stones
- " " 18 " 1/8 " " 4 " " "
- " " 23 " 1/4 " " " " " "
- " " 24 " 1/8 " " " " " "
- " " 25 " see cor " " " Lime Stones "
- " " " look new witness Trees
- " " " Burr Oak 10 S 35° 50' E 196
- " " " Black Oak 5 S 50° 43' W 155 1/2
- " " " Hickory 2 N 64° 31' W 171 1/2 var 6° 50'