

A Record and Plat of a Survey made on Sec Thirty five Town Three Range Ten East

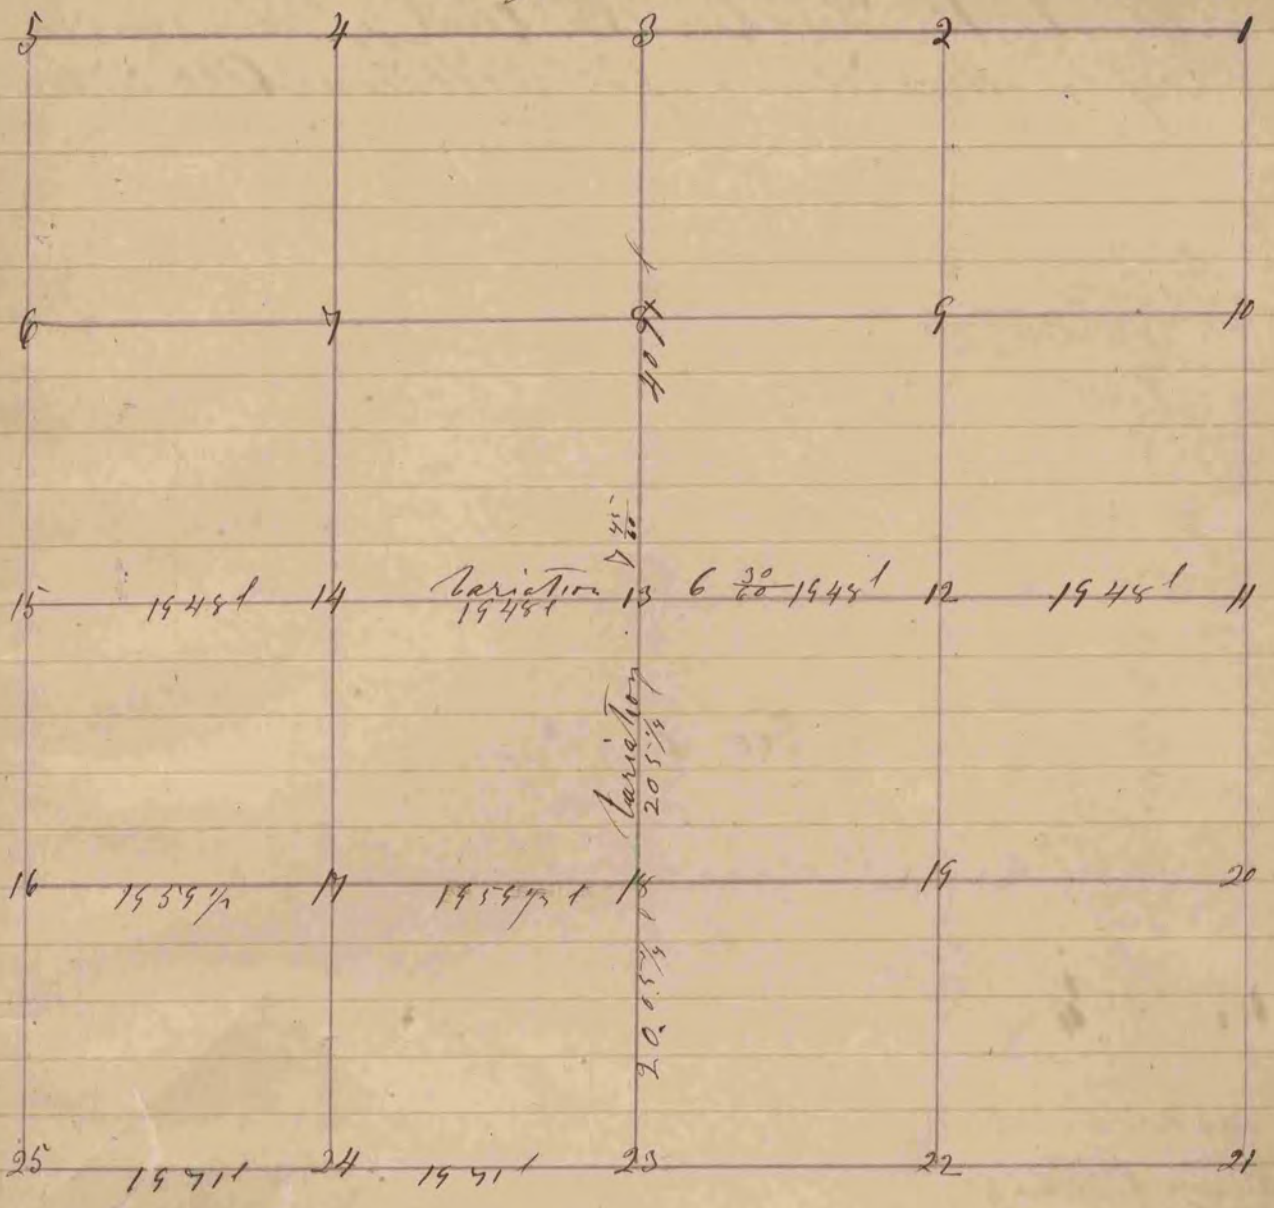


Fig 13 Stake on the Prairie no bearings
 18 " " " " " "
 17 " " " " " "
 24 " " " " " "

The above Survey was made The second day of Sept
 1858 Magnolia
 Joseph Church
 County Surveyor of
 Rock County Wis