


of Record and plat of a Survey made on the ten townships Range No. 6

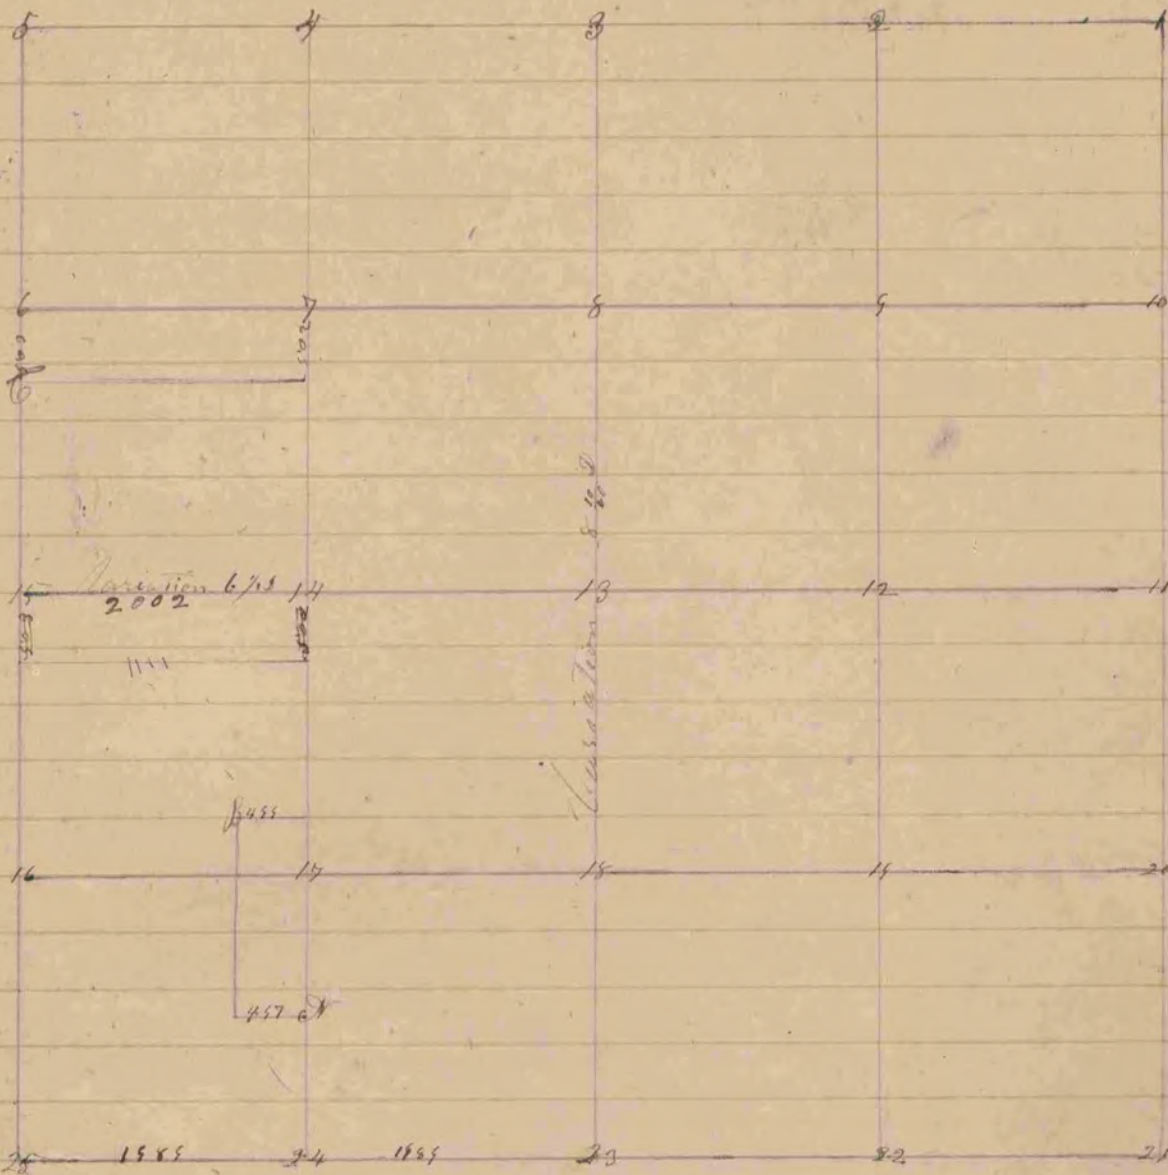

A 24 N 0 15 of 15 W 45
 Letter A N 0 14 of 15 W 45
 B 15 of 15 W 12 0
 C N 0 14 of 16 E 35
 D N 0 12 of 13 W 57

The above Survey was made Feb 17 1856,
 Joseph Chauncey
 County Surveyor
 Hamilton County, N.Y.