


Survey of section town one Range fourteen and record for the same

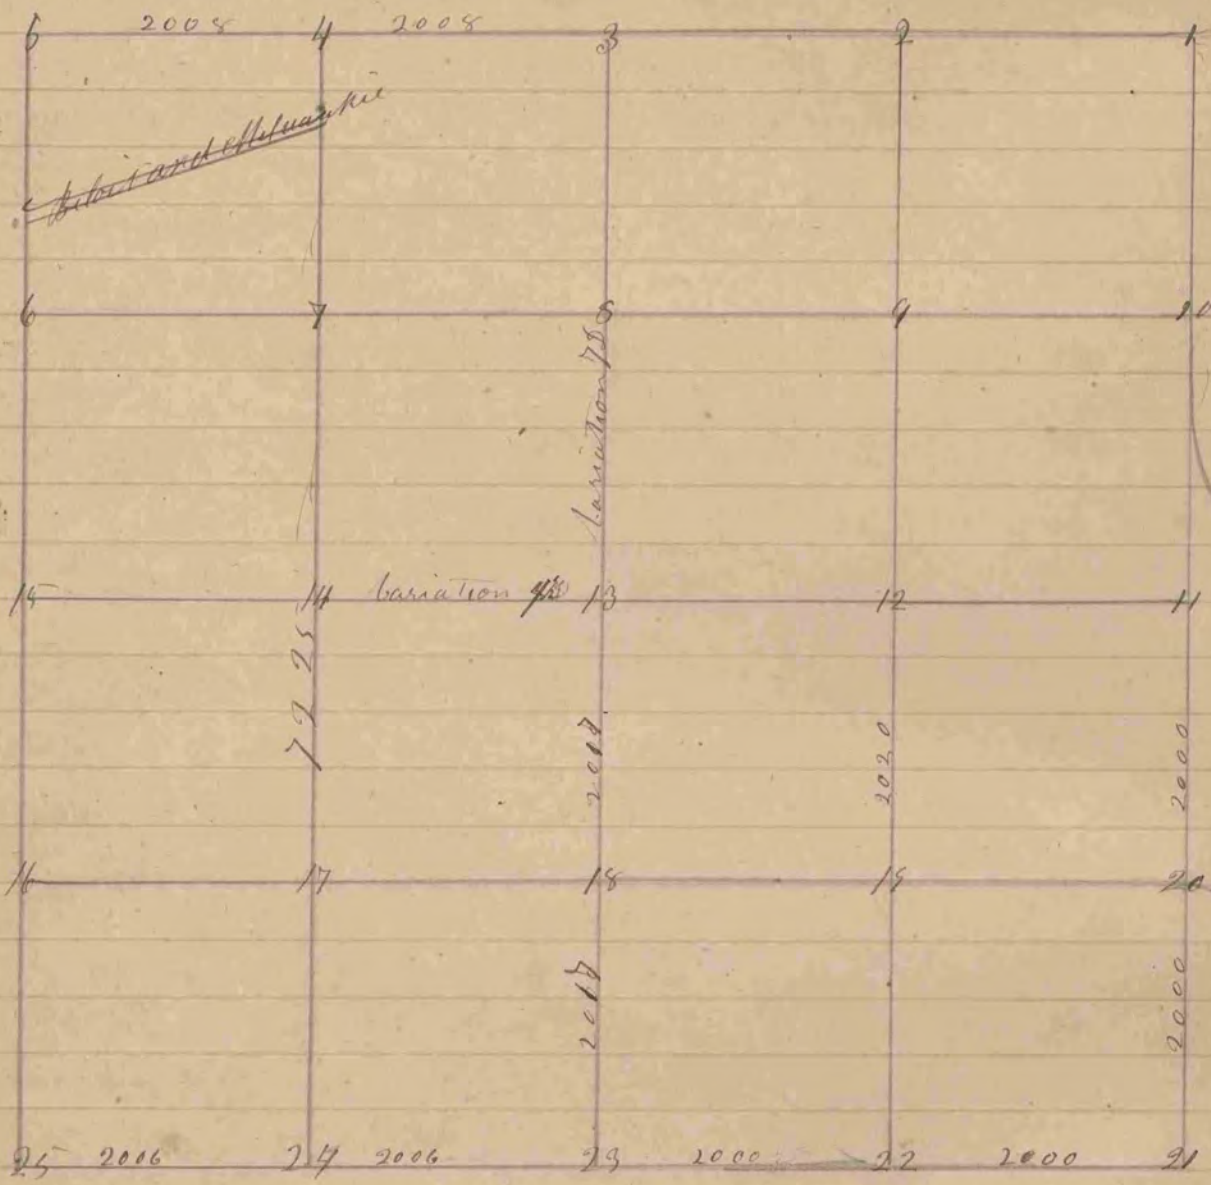

From Fig 24 to Beloit and ethluaukie is 7215 links
 Fig 7-14-17 & 24 Stone and Stake put in the ground
 Fig 15 & 18 Stake and Stones Joseph Church
 The above survey was made Sept 15th 1855
 County Surveyor
 Stark County Wis