


Plat and plat of a survey made on the 15 town three corners  
East

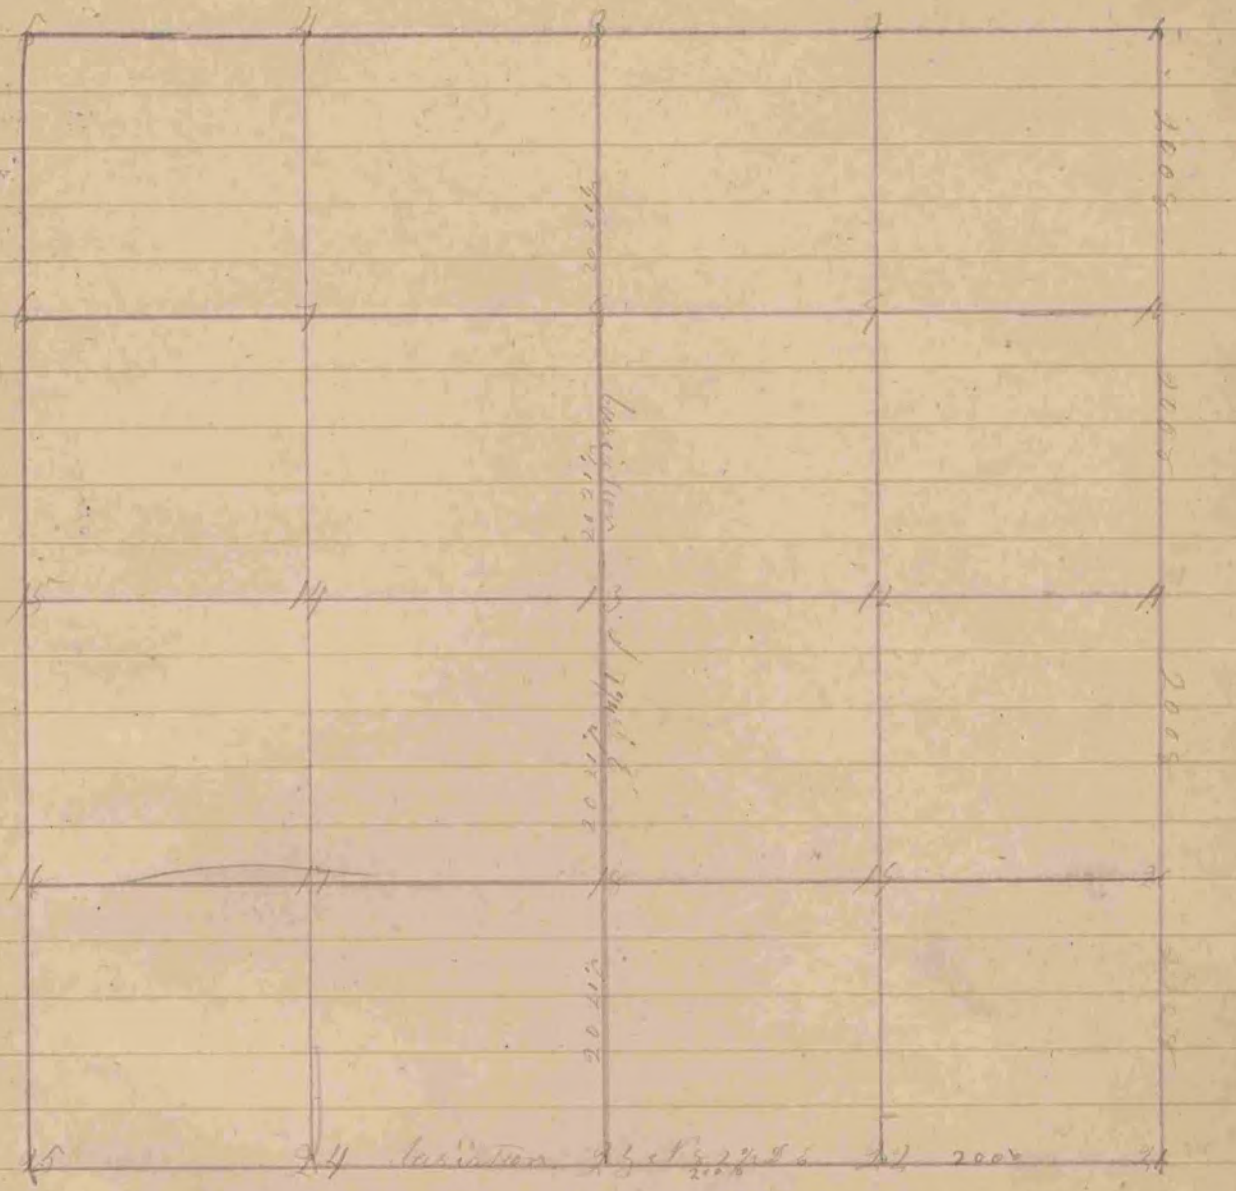

- 13 Centre of the plat No 12 at 56 to 200  
20 of 24 1/2 W 16 1/2
  - 11 no bearing this made corner plat to corner No 15 at 18 1/2 W 55  
Stone school house at the corner of 20 1/2 W 16 1/2
  - 17 No 12 at 24 W 41 No 9 Thump 16 at 24 W 34 1/2
  - 10 No 16 at 56 W 17 1/2 No 12 at 32 W 21 1/2
  - 7 No 20 at 56 to 53 No 18 at 14 W 57 1/2
- The above survey was made the 21<sup>st</sup> day of Dec 1855  
Joseph Church to corner surveyor of the town