


The following is a record & plat of a Survey made by me on Sec 9 Turtle Sept 1882 - J. A. Holmes Co. Surveyor.



The following is a record & plat of a Survey by me on Sec 6. Turtle Nov. 1882 - J. A. Holmes Co. Surveyor.

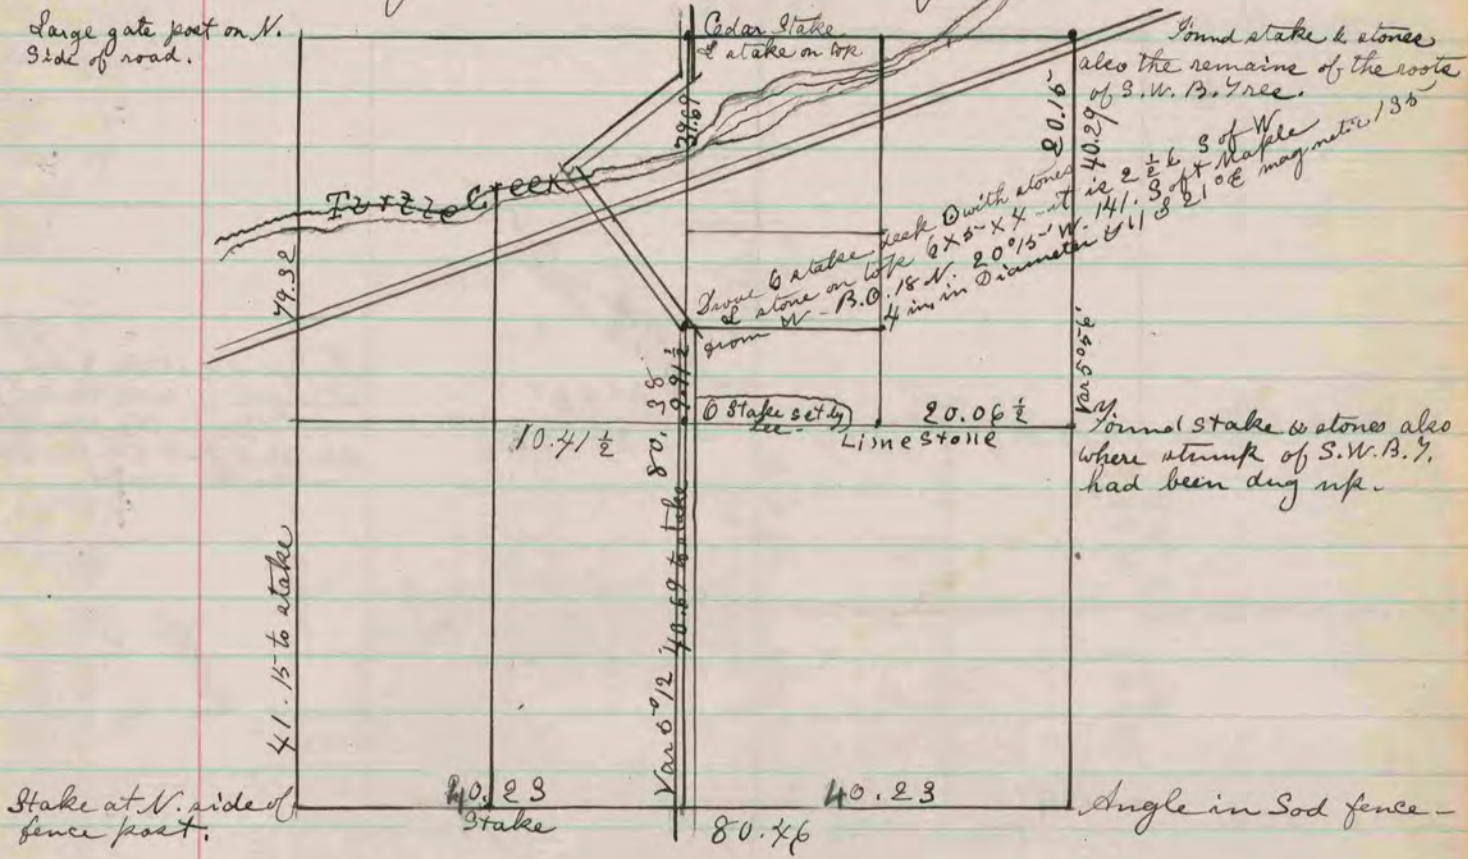