


A Record and plot of a Survey made on
Section one Town four Range fourteen East

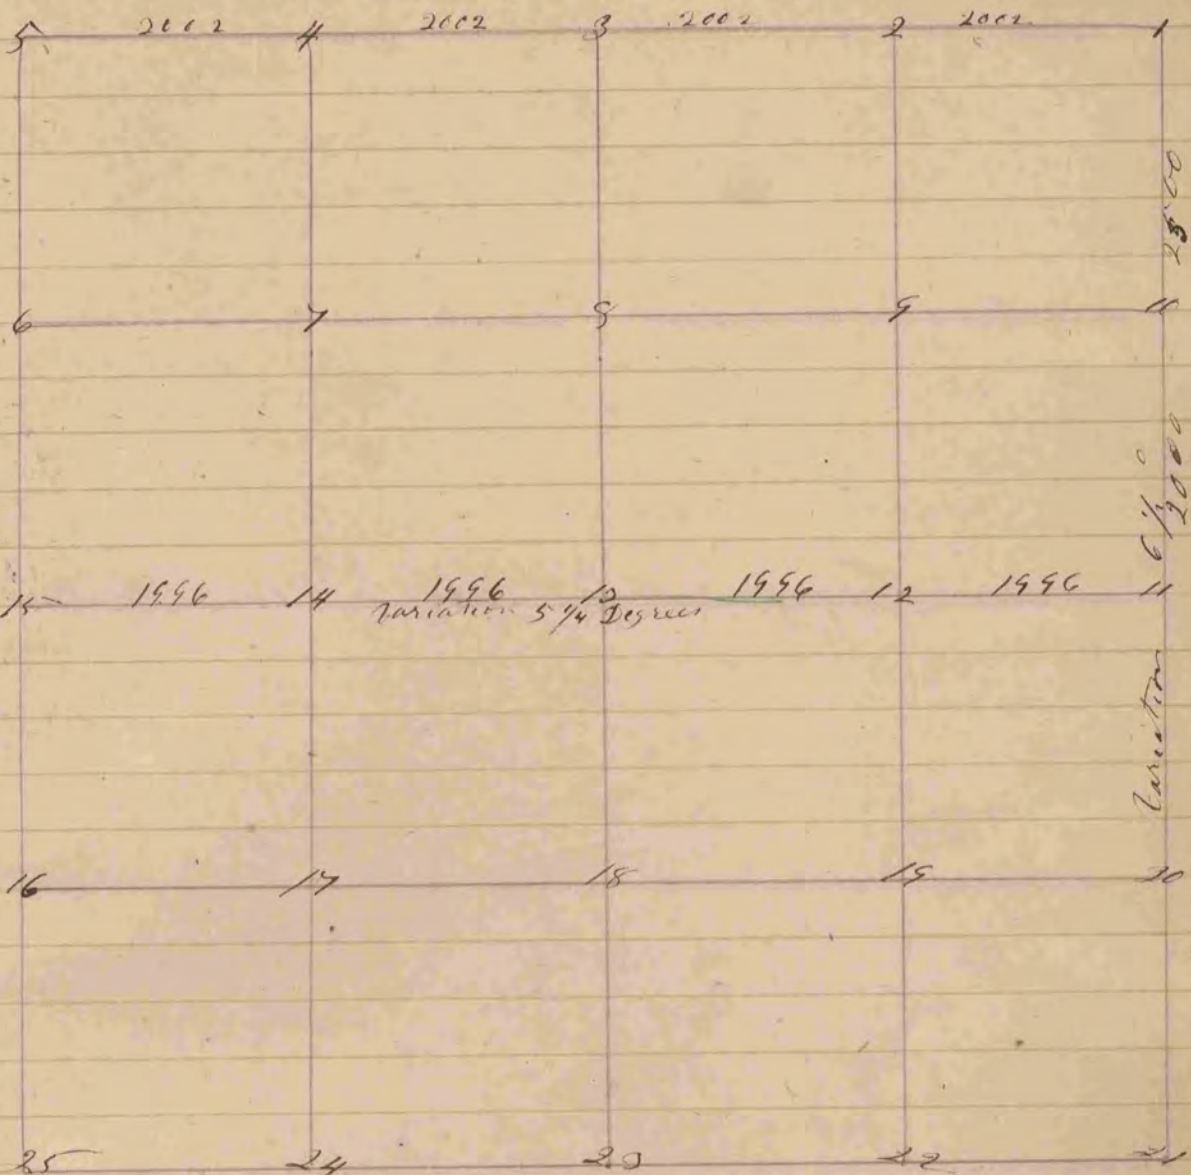

- Fig 13 Stake in the Marsh
- 8 in
- " 10 Maple 2 S 61 71 42 7
- " 2 S 36 71 75 links
- " 11 one of the trees cut bearings Lima

The above Survey was made the 14 day of Apr
1857

Joseph Church County Surveyor
Rock County Wis.