


A hand and plot of a survey made on the 11th of Dec
between town three fence line east

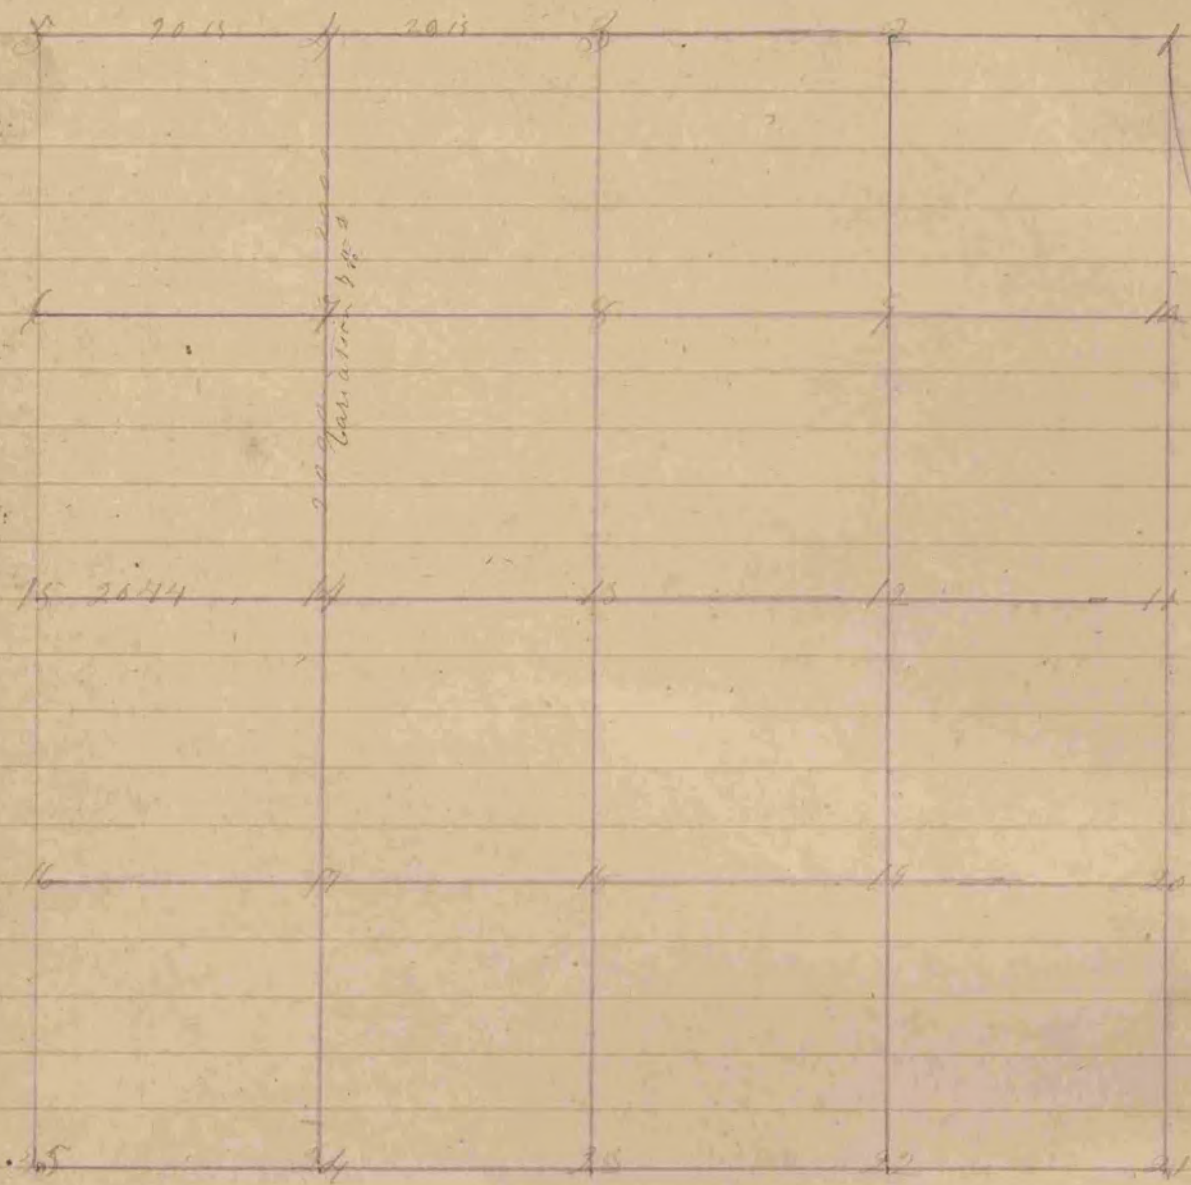

From 5th 15 to Elevation over no 147th found stake by stump marker

by 14 found stone

7 Bar C 20 of 57 1/2 to 55

by 0 14 of 71 & 68

4 W C 20 of 63 to 20

W C 24 of 70 & 60

610 In preceding page marked by tin

with stone survey was the 21st day of Dec 1851

Joseph Church County Surveyor of Rock County

1851