


COUNTY SURVEYOR  
RECORD 1859-1906

The above is a record & plat of a Survey made  
by me Sept 19<sup>th</sup> 1881 on Sec. 20 Clinton -  
R. K. Lee, Co. Surveyor.

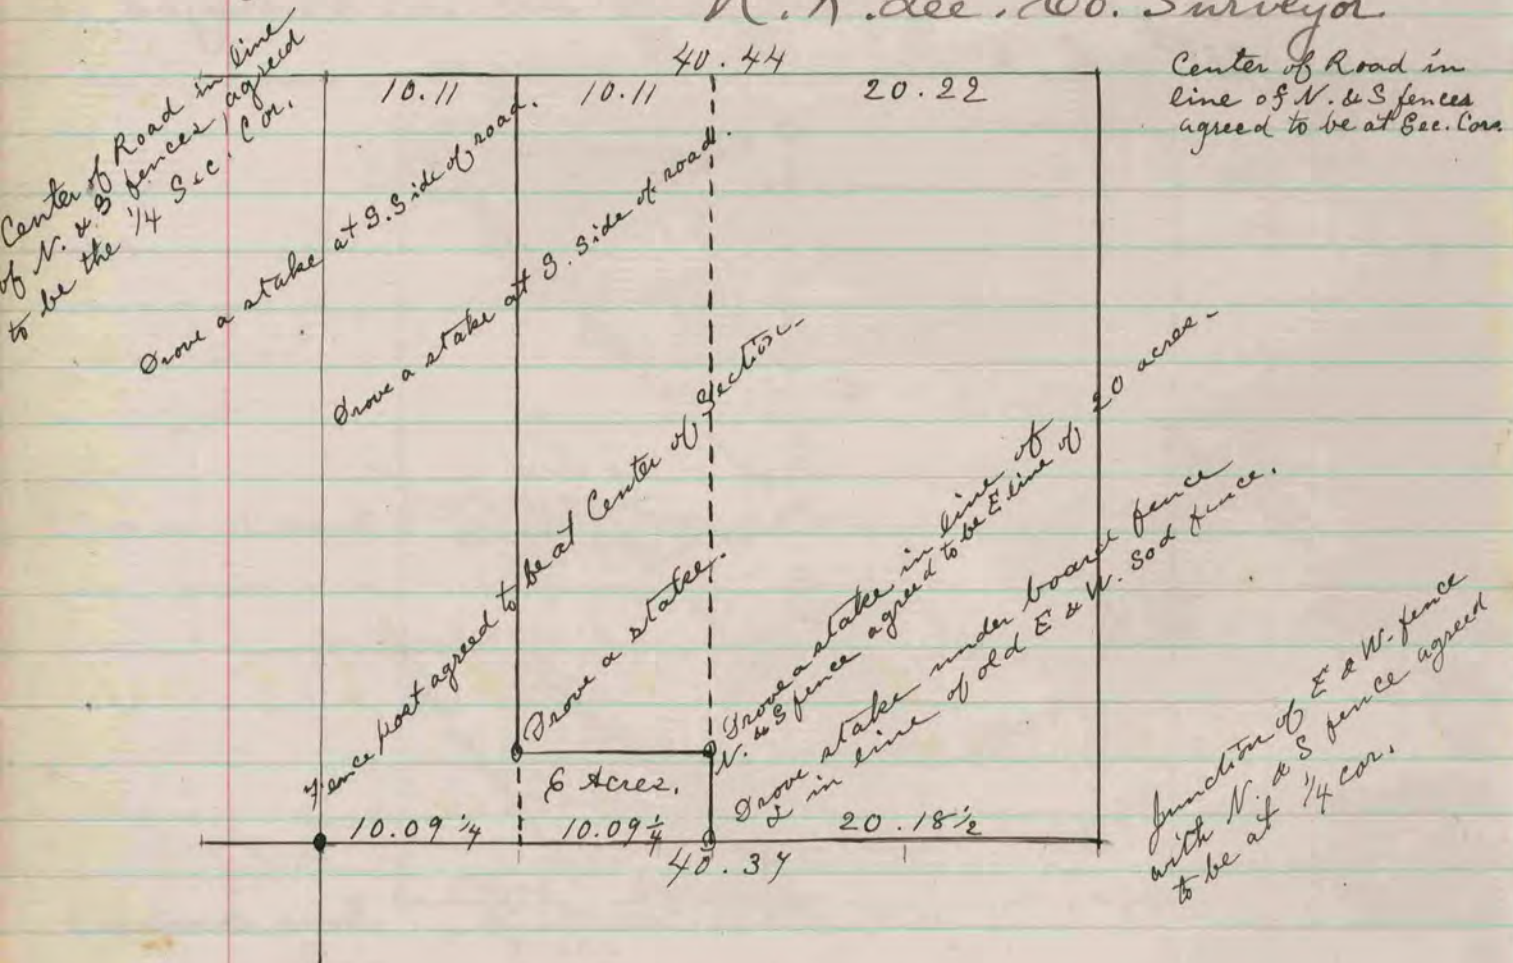

The above is a record & plat of a Survey made  
by me Sept 20<sup>th</sup> 1881, on Sec. 28. Clinton  
R. K. Lee  
County Surveyor.