


A Record & Plot of Survey made on Section
Twenty five Town Three Range Eleven East

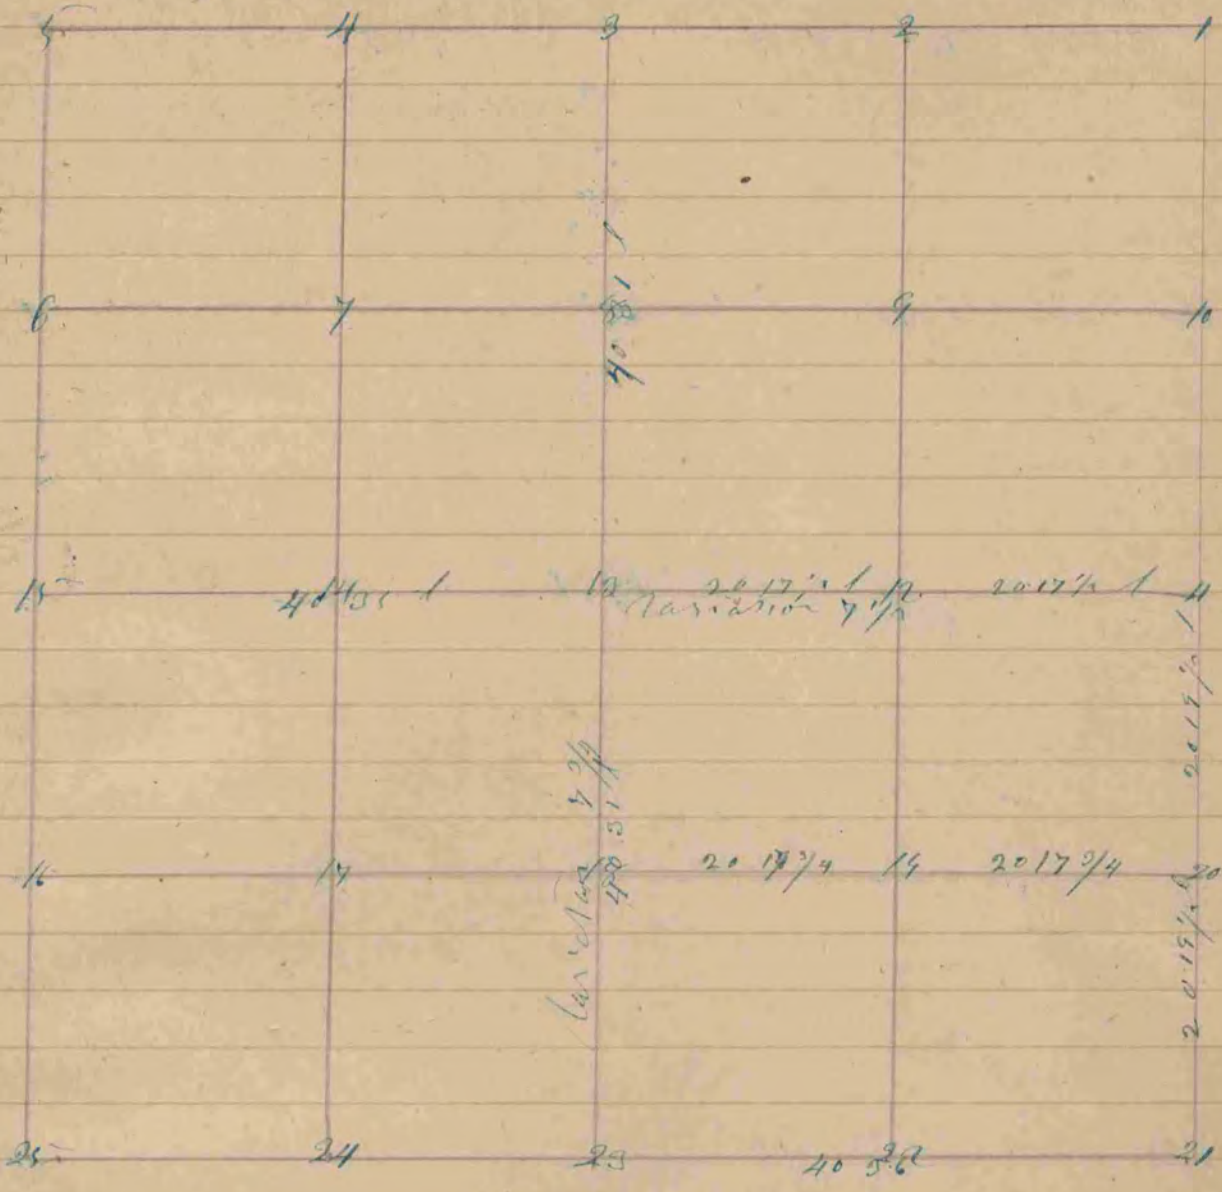

- Fig 19 Stake no Bearing
- 19 " " "
- 20 " " "
- 21 Stake in the Centre of High Way no bearing

The above Survey was made June 16th 1818
Centre Joseph Church County Surveyor
of Rock County Wisconsin