


A Record and plat made of a survey on Sec 33, Thirty
Three town tree Range (12) Twelve East

Rock

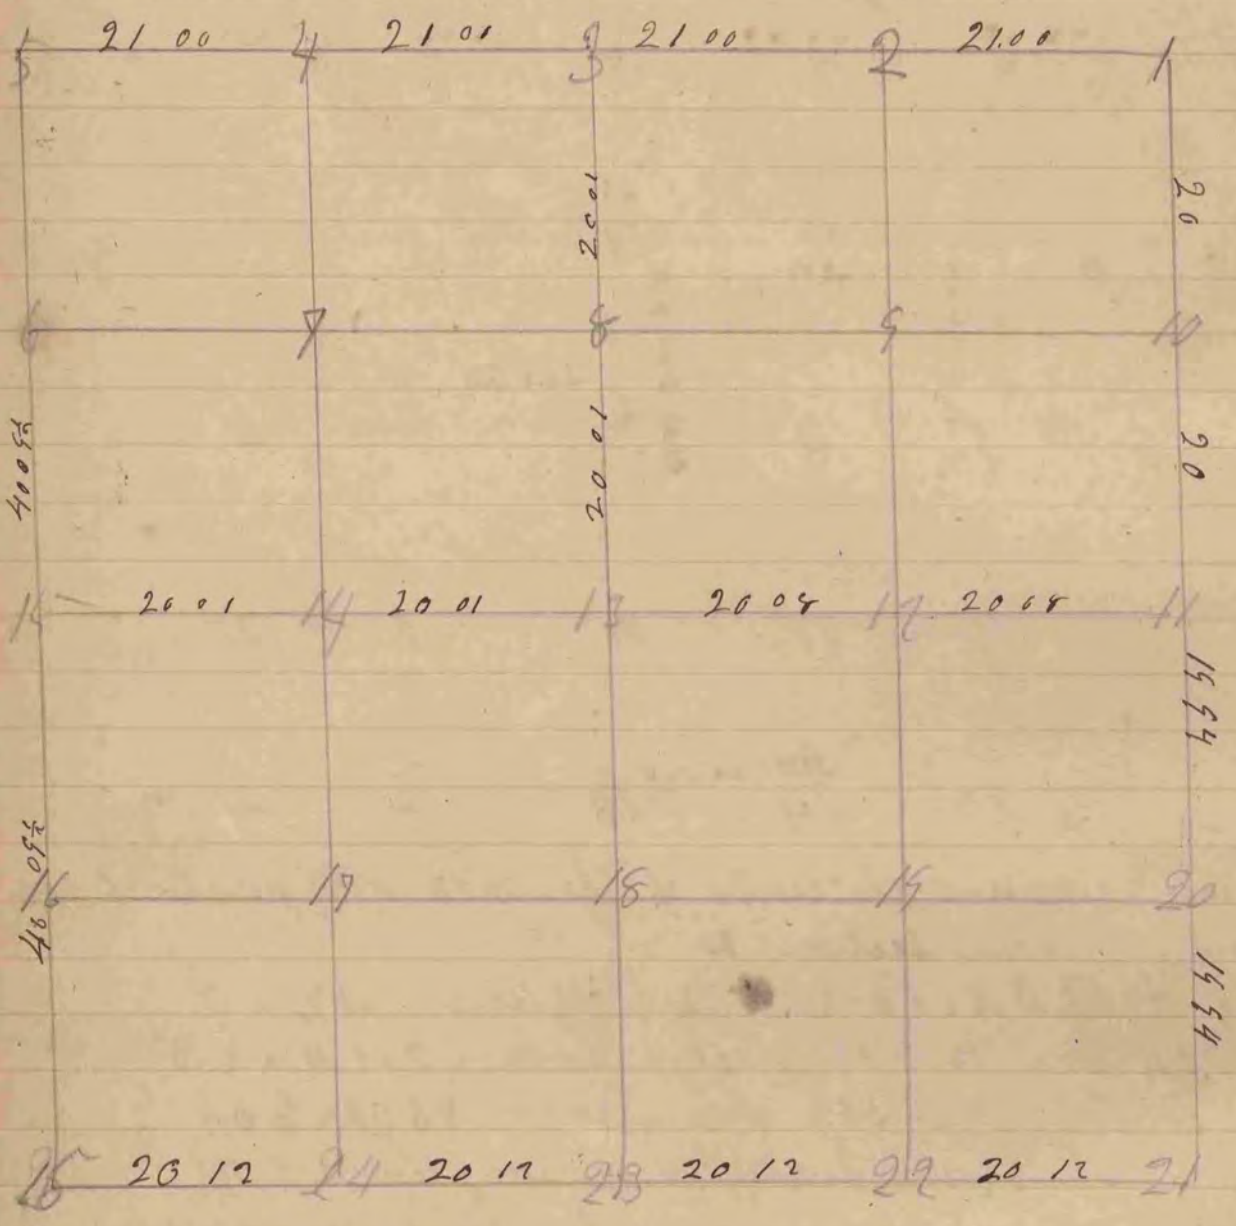

- Fig 13 Black C & S 12 1/2 W 75 links
- 5 Bar O 16 N 7 1/2 E 152 =
- W O 20 N 70 W 204 =
- 15 Black O N 34 1/2 E 103 =
- = = S 10 1/2 E 109
- 8 Stake no trees
- 23 Stake

The above survey was made April 5th 1855
by Joseph Claure County Surveyor