


cf Record and plat of a survey made on section
thirty five town one Range Eleven East

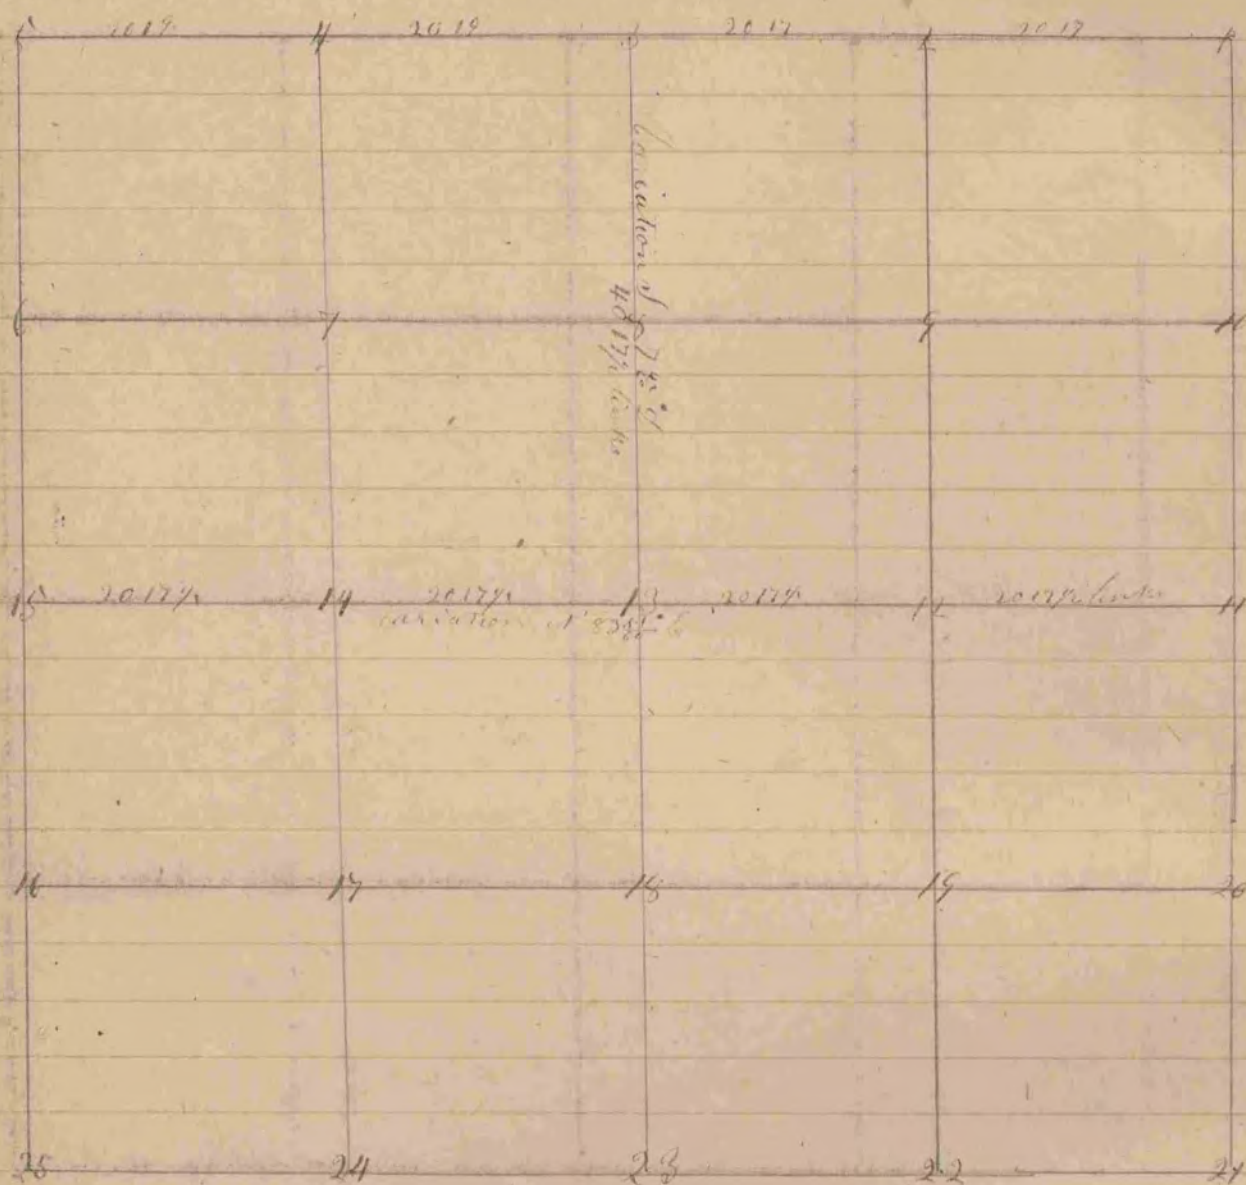

- 18 71° 0' 20 N 67 1/2 46
- " " 20 N 85 1/2 6 95
- 12 B 0 12 N 20 1/2 W 225
- " " 16 N 15 1/2 W 353
- 14 N 0 24 N 70 W 225
- " " 20 N 67 W 66
- 4 W 0 20 N 55 W 120
- 2 B 0 " N 66 E 70

The above survey was made March 26th 1856
Joseph Church
County Surveyor
Rock County