

A Record of a Survey made on Section Thirty Six in
in the Town of Newark

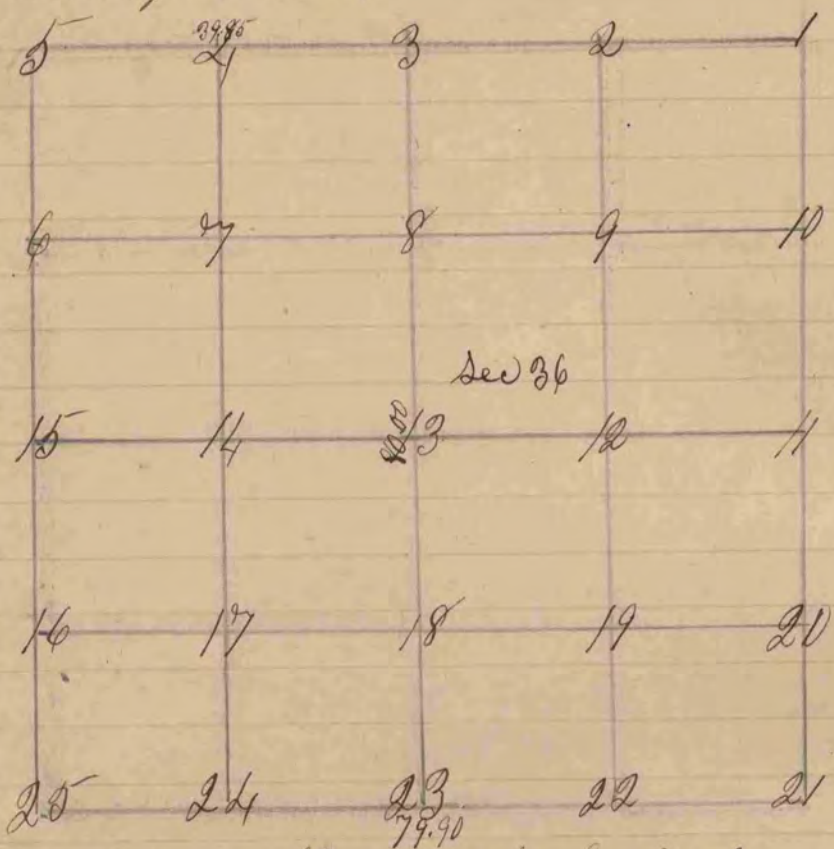


Figure 13 represents the centre of the Section
 by 13 Br 0 24 S 35 E 108 also Br 0 10 S 76 E 91
 The above survey was made February 27th 1852
 Peter M. Bean County Surveyor