

87

A Record and plat of a survey made on See 6 Town  
two Range ~~to~~ East

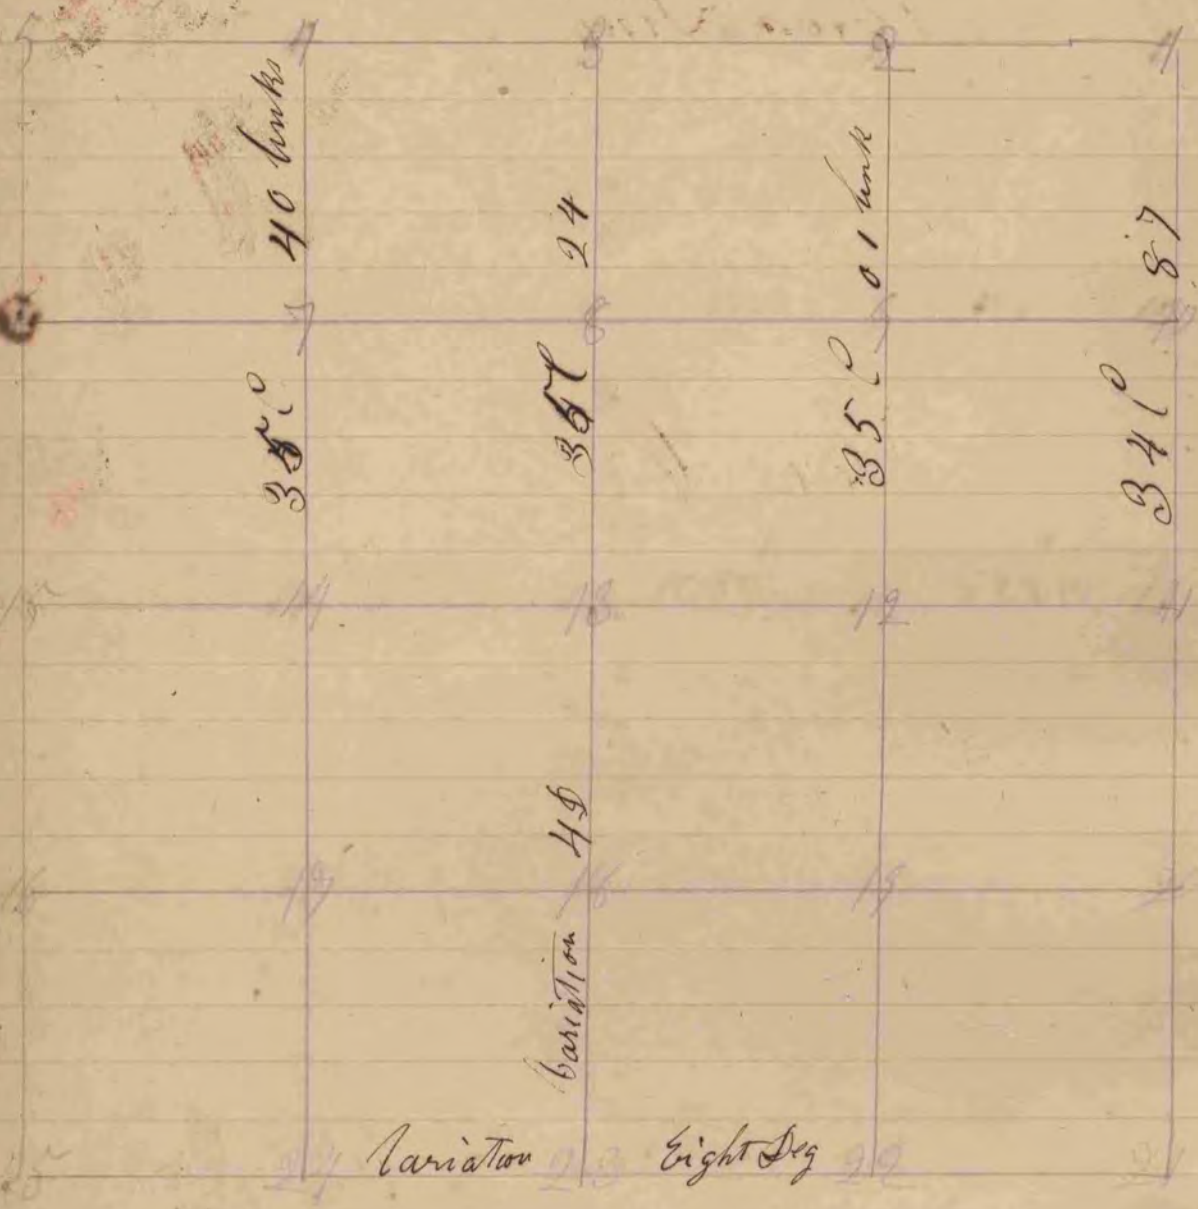


Fig 13 Bur O S 11 E 85 links  
 - - - N 45 W 109 - - -  
 12 Black O S 86 E 203  
 Bur O N 53 E 156  
 14 - - - S 58 E 47  
 - - - S 65 W 21 the above notes were taken with  
 a variation of 4 D on the Compass  
 5 Bur O S 28 E 191 links  
 S 15 W 195  
 2 - - - S 9 E 225  
 S 45 W 245 The last were taken with 7 1/2  
 The above survey was made May 11th 1855  
 Joseph Church County Surveyor