


B3
A plat and survey made on Sec Elenen town two Range
Elenen East together with the Record

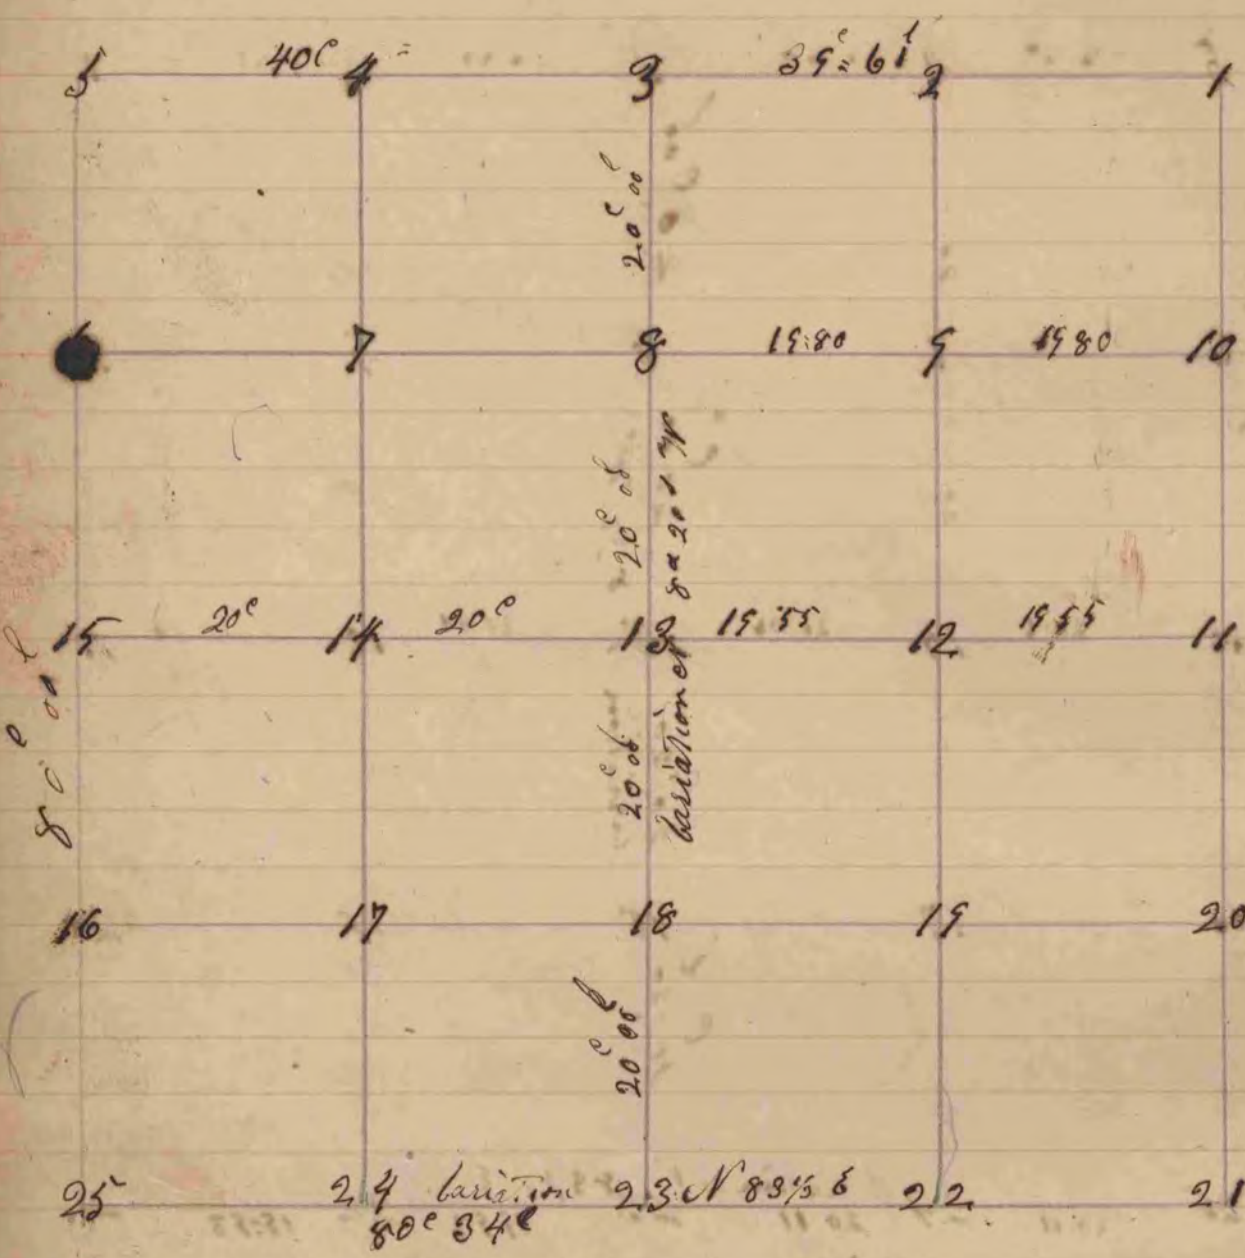

- Fig 13 represents the Centre of Sec
 Bar 0 = 16 N 65 1/2 E 68 links lime Stone
 Fig 12 Bar 0 N 37 W 136 links lime Stone
 = 18 Black O N 2 1/2 E 190 = Stake
 = 8 Bar 0 N 20 E 57 = lime Stone
 = 7 = S 56 1/2 W 215 = Stake
 = 5 Apple tree S 11 E 85 = lime Stone
 = 15 Cotton Wood 2 S 74 1/2 W 117

The above survey was made the 14 day of Apr. 1855
 Joseph Church County Surveyor