


M-134

Found stake surrounded by 3 limestone and three burnt also found stump of N.W. RT.

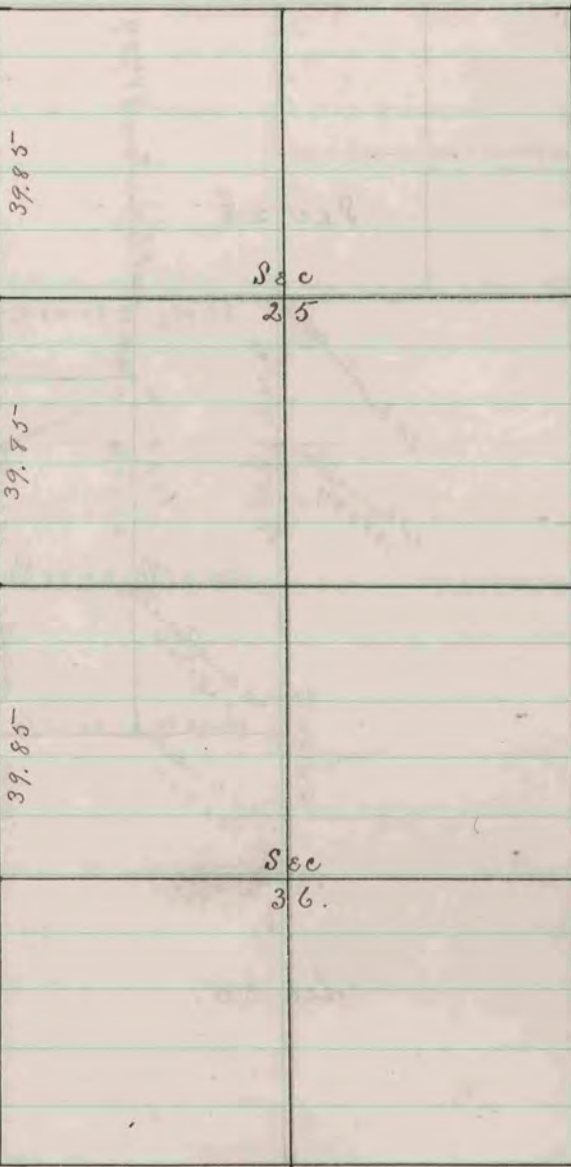

Found stumps of both RT's & remains of old stake. Drove new stake in place of old & surrounded by 6 cobble stones.

Drove 3/4 inch iron rod also drove 3/4 inch iron rods 15 links E & W. Drove stake north of rod at corner. Took B.T. WO. 7 N. 5° 15 W. 2.59 WO. 8 N. 19° W. 29 1/2

Found stone mon. & N.E. RT. and where stump of S.E. RT. had decayed. Took new B.T's. Hickory 5 S. 39° E. 32. B.T.O. 7 S. 46° W. 18 1/2 Hickory 6 S. 64 1/2° W. 49.

The above is a record & plat of a survey made by me on sections 25 & 36 Beloit, June - 1882.

Edward Rieger
County Surveyor