


The above is a plot and record of a survey made by me, Oct. 1<sup>st</sup> & Nov. 4<sup>th</sup> 1870, on Section 12 Rock

Edward Ringer  
Dep't. Co. Surveyor

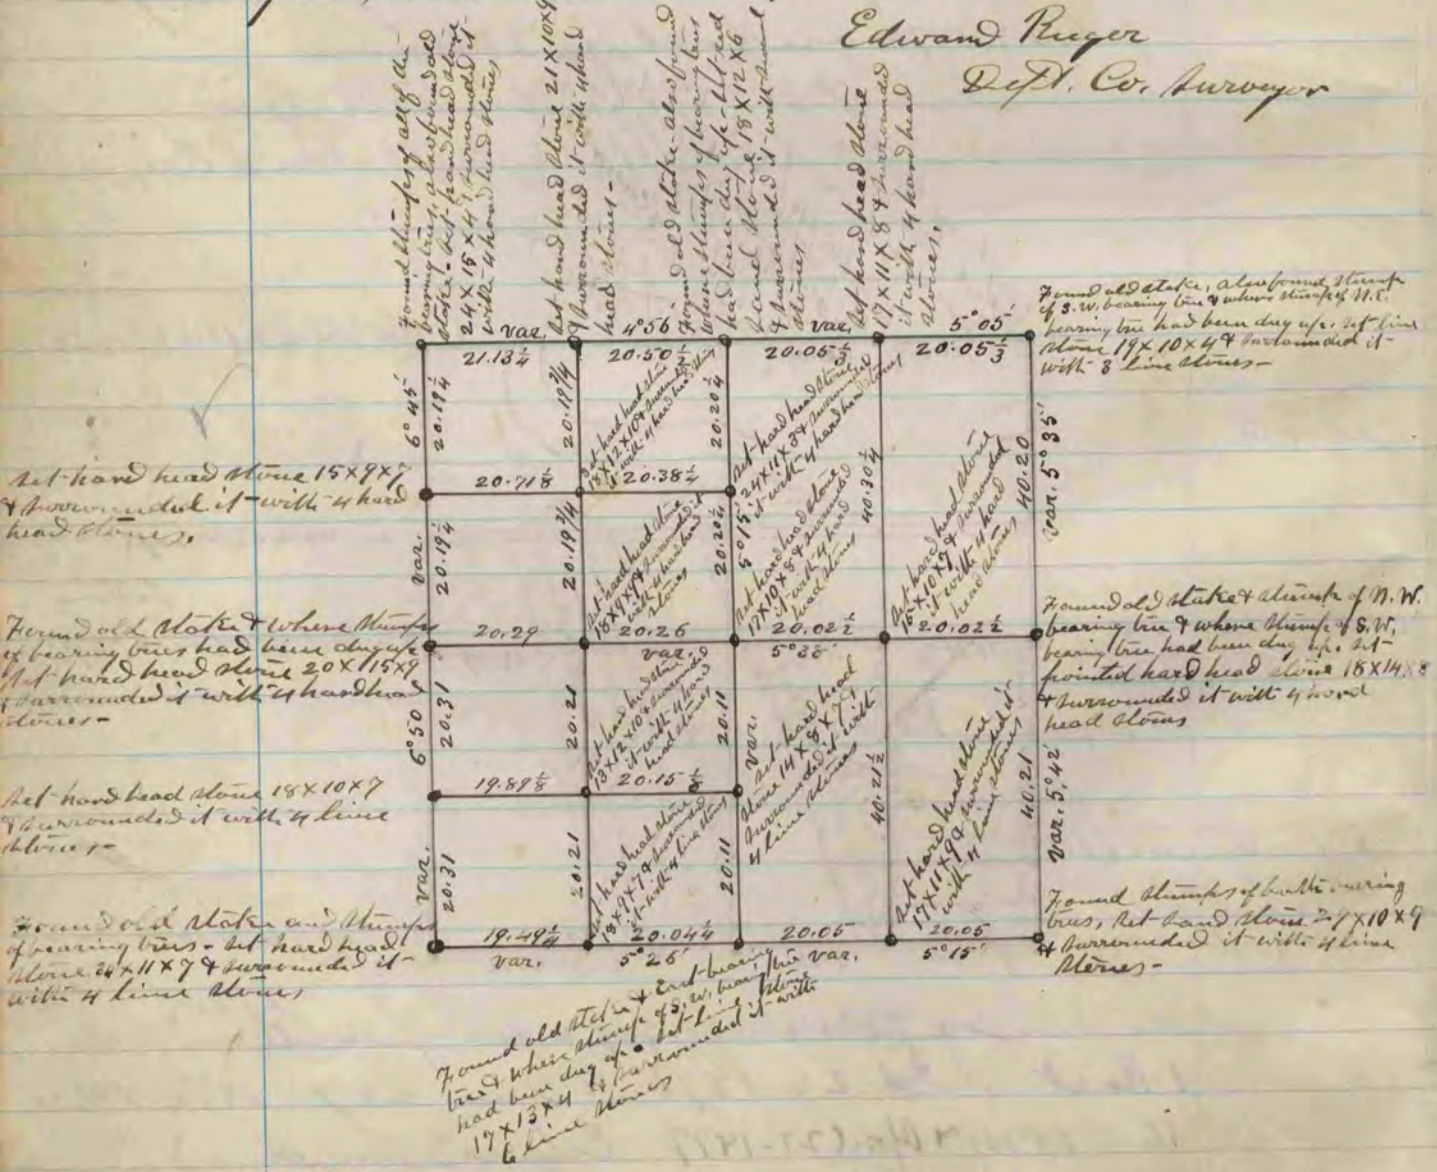

The above is a plot & record of a survey made by me, Nov. 21, 22 & 23, 1870, on Section 19 Newark - Edward Ringer  
Dep't. Co. Surveyor