


COUNTY SURVEYOR
RECORD 2 1869-1900

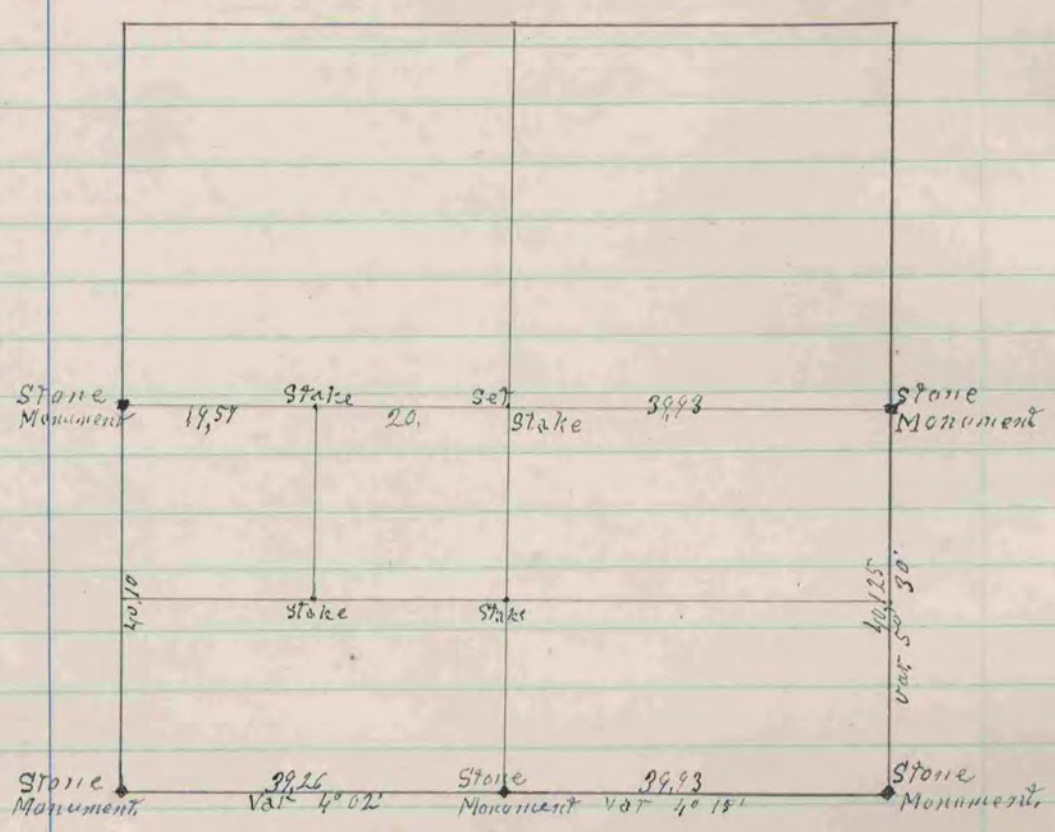

The above is a record and plat of a survey made
by me on Sec. 31. T. 2. R. 13 (LaPrairie) Nov. 18th 1881.

John A. Holmes
County Surveyor

COUNTY SURVEYOR
RECORD 2 1869-1900