


RECORDS 1869-1900  
COPYRIGHT 1900

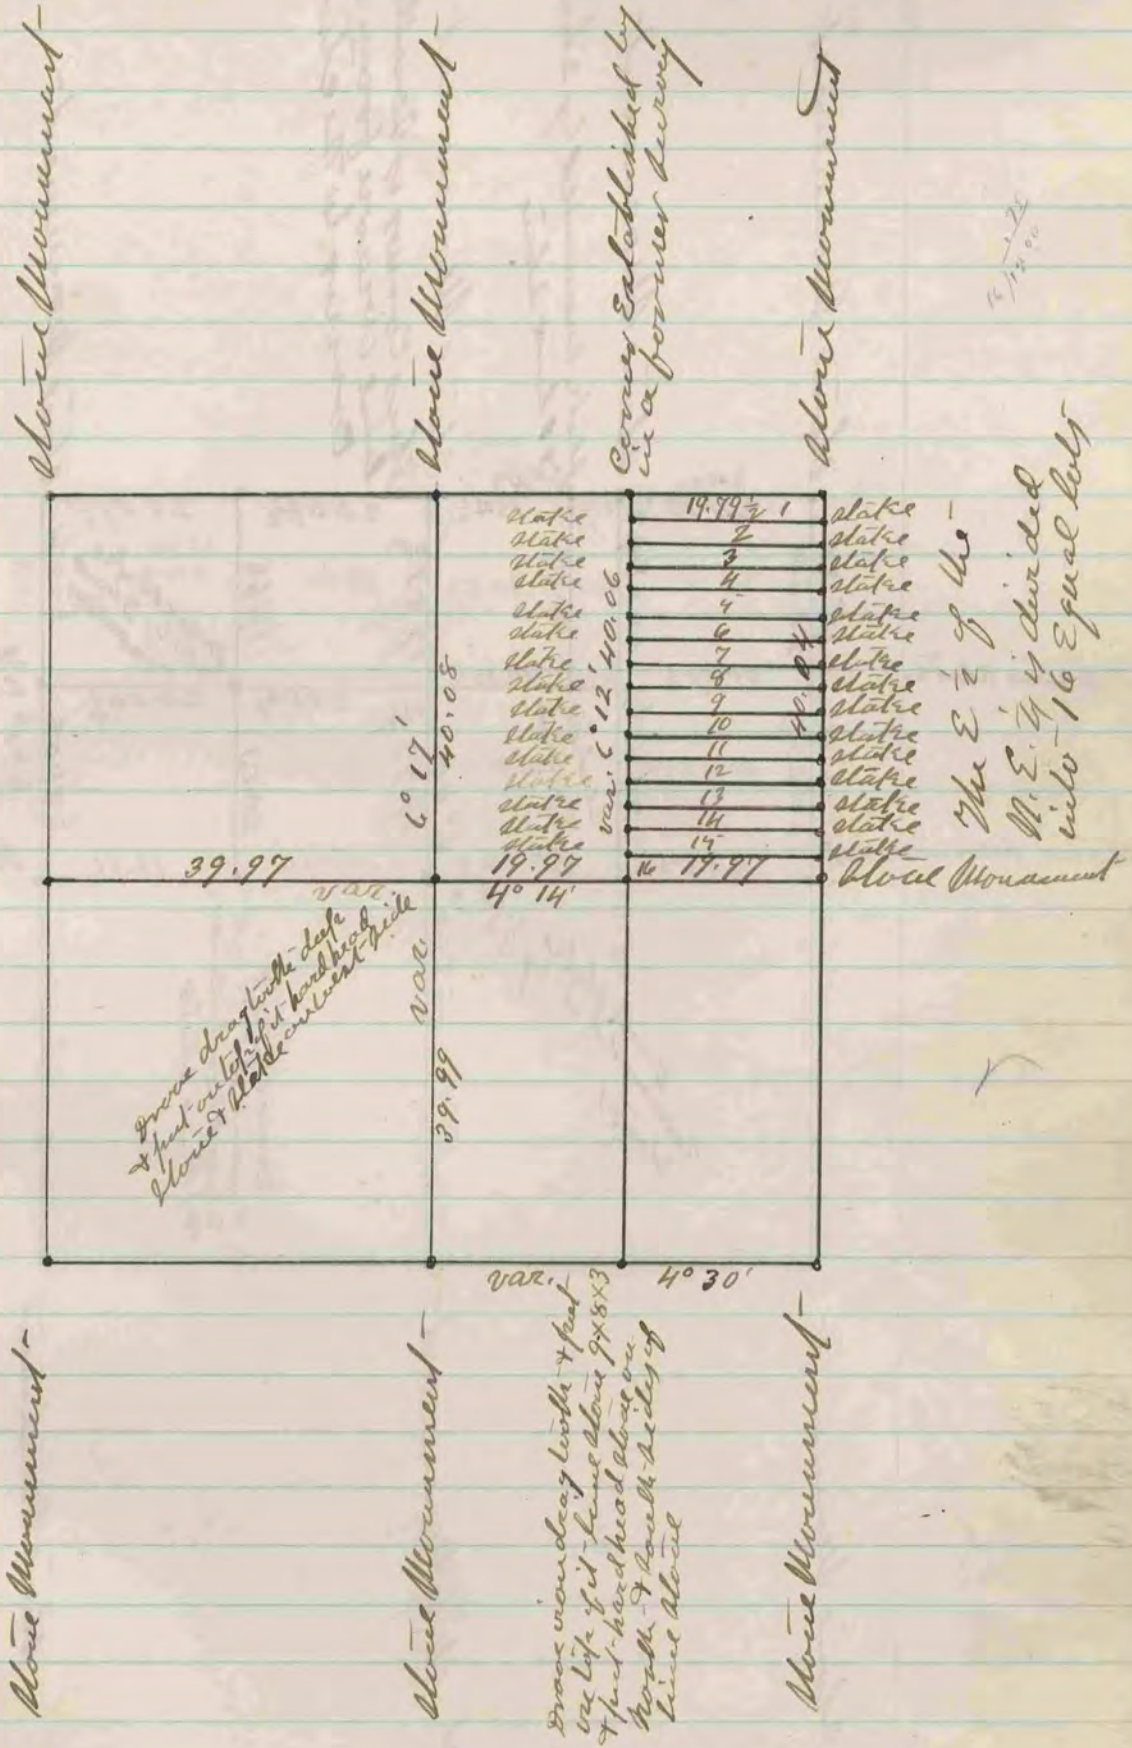

The above is a record and plat of  
a survey made by me on section  
23 Harmony Nov. 15, 16, 17 & 19 - 1877

Edward Rieger  
County Surveyor