

SECTION CORNER MONUMENT CONDITION REPORT

I, John Krebs, Wisconsin Registered Land Surveyor No. S-1878, hereby certify that I have located the section corner monument and all ties for the South Quarter corner of Section 07, T 03 N, R 13 E, Harmony Township, Rock County, Wisconsin as per tie sheet filed by Donald A. Barnes, Wisconsin Registered Land Surveyor No. S-1216, dated July 5, 1994. Rock County Index Number ~~J-5~~ **J-3** **(JCM)**


John Krebs

Date



ROCK COUNTY SECTION SUMMARY

SECTION 07, T03N, R13E, TOWN OF HARMONY

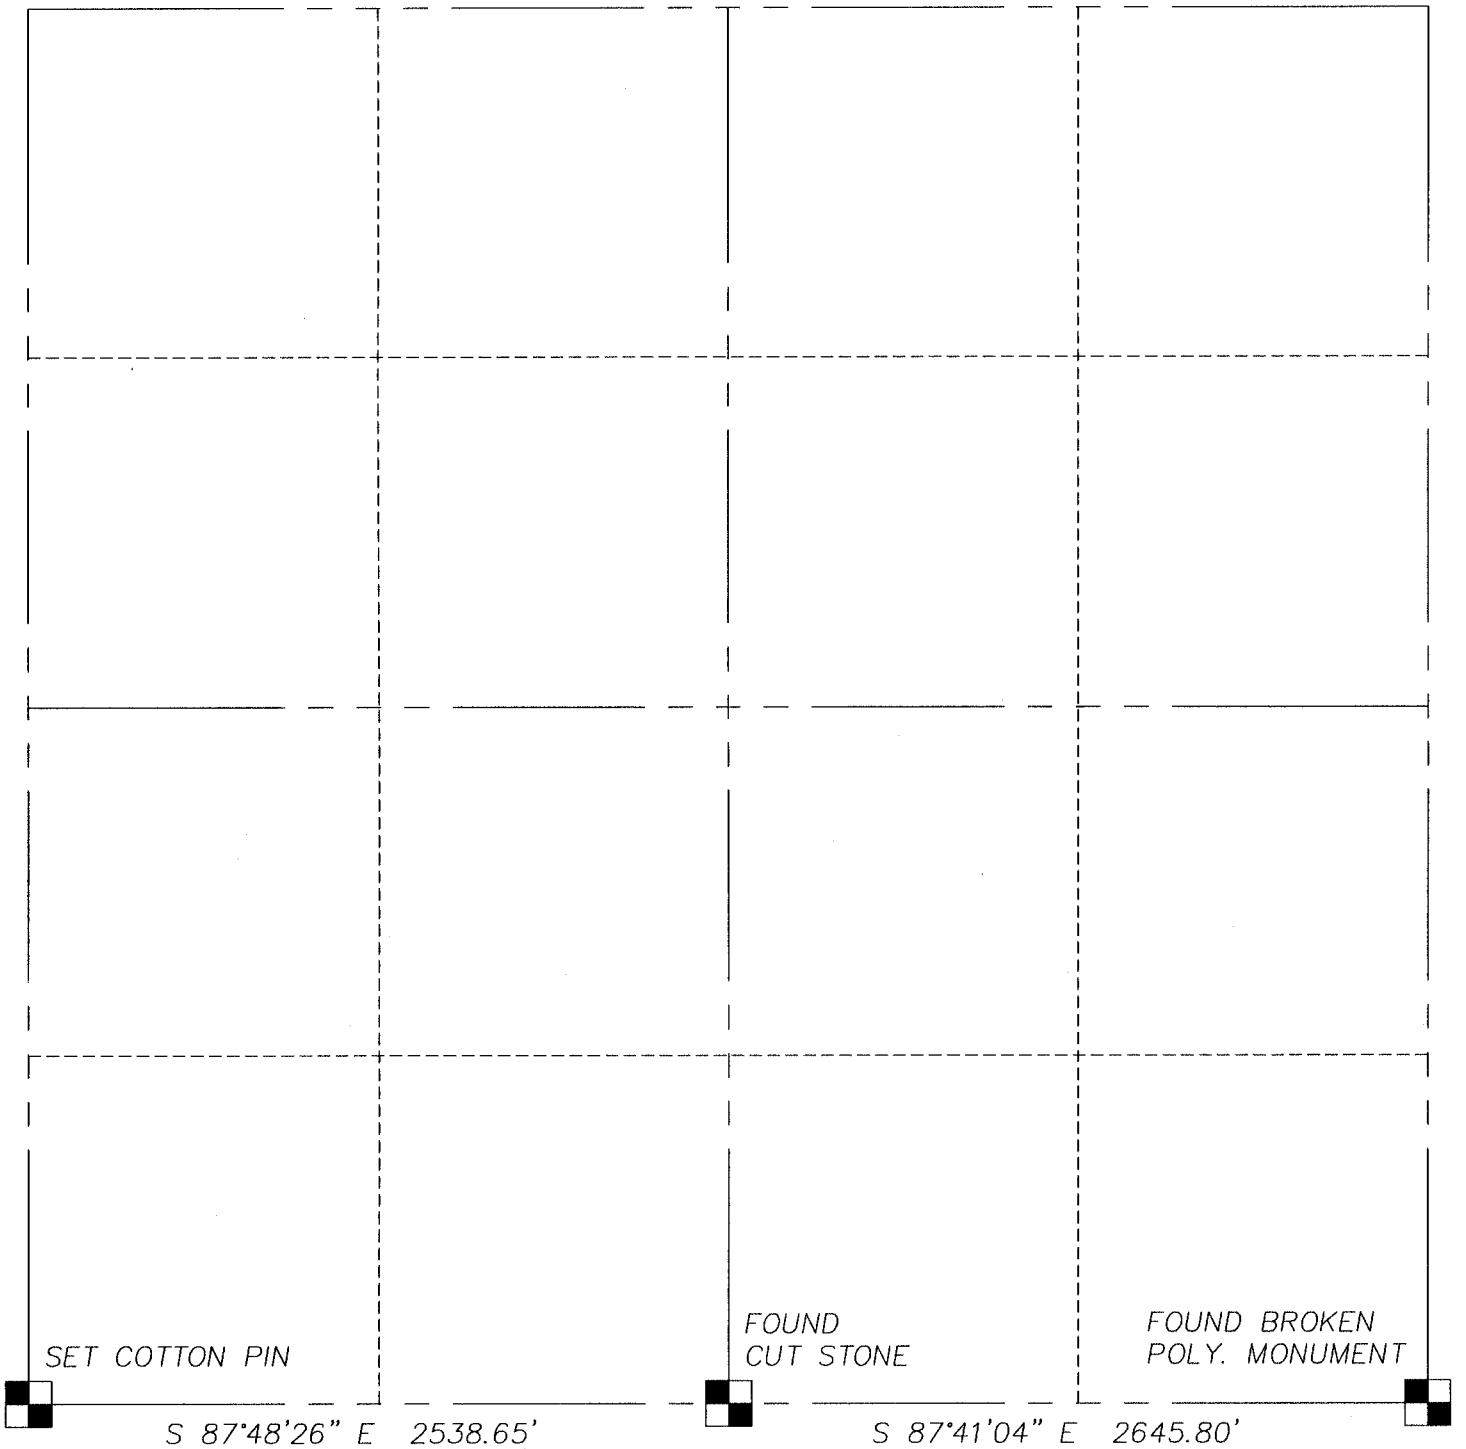

BEARINGS ARE REFERENCED TO THE WISCONSIN COUNTY COORDINATE SYSTEM, ROCK ZONE.

J-003