Paper	we1at	nini
, caponi	MOTO.	1171.17

U.S.

Black no....


PUBLIC LAND SURVEY MONUMENT RECORD

For Public Land Survey Corners in:

WI ADMINISTRATIVE CODE A-E 7.08 REQUIREMENT

T. 3N., R. 12 E

CORNER CODE INDEX

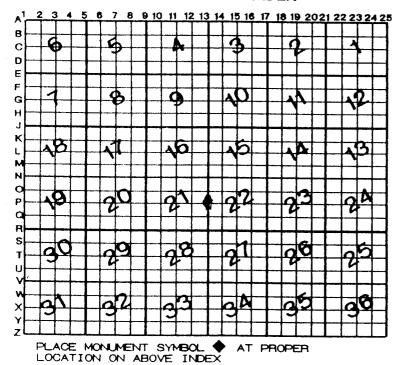

JANESVILLE TWP ROCK COUNTY WI

IF AVAILABLE ROCK COUNTY COORDINATES PERFERRED

North Elev. East Hor. Datum _____ Vert, Datum LATITUDE _ ELLIPS. HT. LONGITUTE TRAVERSE (X) BASED ON THE FOLLOWING CONTROL:

♦CORNER MONUMENT

WITNESS MONUMENT

BEAFINGS ARE

(a)

							ET		2
FIELD	BOOK	PAGE #				SHE	ET	OF	
SHOW	A PLAN VIEW	DRAWING DEF	PICTING THE	CORNER	MONUMENT	AND SUF	ROUNDING		
	CAL FEATURES,								
	IG & ZONING COM						•		

JA577

- (B) Describe any record evidence, monument evidence, occupational evidence, testimonial evidence or any other material evidence you considered, and whether the monument was found or placed.
- 1857 RUGER VOL 1 PG 97 ONE OLD W.T. STANDING, WHITE OAK 24 S43E 2 OTHER W.T. CUT DOWN. VAR 8-32 TO SE COR SEC 21, VAR 8-37 TO NE COR SEC 21, VAR 7-12 2649.90 TO CENTER OF SEC 21, 5276.70' TO W 1/4 COR SEC 21.
- 1859 RUGER VOL 1 PG 98 SAME AS FIG 11 SEC 21 [VOL 1 PG 97] VAR 7-55 2618.22 TO CENTER OF SEC 22.
- 1874 RUGER VOL 2 PG 139 EST BY SELF BK 1 PG 107.
- 1881 LEE VOL 2 PG 319 FD WT AT 1.32' S.E. SET W.O STAKE SURROUNDED BY 3 HHS, RED ONE ON N. SIDE VAR 6-15 1325.94 TO FD REMAINS OF STAKE SET BY RUGER ABOVE NEW STAKE AT S $1/16^{\text{TH}}$ COR OF NE 1/4 SEC 21.
- 1964 THOM MAP #5654 $\frac{1}{4}$ COR ACCORDING TO OCCUPATION. 2658.0 TO SE COR SEC 21.
- 1964 THOM VOL 6 PG 133. 2658.0 TO SE COR SEC 21.
- 1975 SCHROEDER VOL 4 PG 5 DUG & FD REMAINS OF STAKE & STONES OF RECORD 4' DEEP. TIE 52.70 TO WEST, TIE 40.00 TO NE, TIE 14.18 TO EAST, & TIE 13.0X TO SOUTH.
- 1975 SCHROEDER FB 1 PG 6 DUG & FD REMAINS OF OLD STAKE SURROUNDED BY HHS OF RECORD ABOUT 4' DEEP. R.R. SPIKE 13.0 TO THE SOUTH & 14.9 TO R/R/(?) ON SOUTH SIDE OF POWER POLE TO THE EAST.
- 1975 SCHROEDER FB 1 PG 7 SET 1"X24 AS REFERENCE PIPES.
 52.70 TO THE WEST, 14.18 TO THE EAST (SW SIDE OF
 UTILITY POLE), 40.00 TO THE NORTH. SHOWS COR IN
 GRAVEL PRIVATE DRIVE ON LINE WITH N/S FENCE.
- 1980 COMBS VOL 6 PG 133 & MAP #5657 1305.01 TO S $1/16^{TH}$ COR OF NW 1/4 OF SEC 22, ANGLE 89-27-35 @ W 1/4 COR SEC 22 FROM TO S $1/16^{TH}$ COR OF NW 1/4 OF SEC 22 TO SE COR SEC 21, ANGLE 90-40-30 AT SW COR SEC 22 FROM W 1/4 COR SEC 22 TO S 1/4 COR SEC 22.
- 1981 BARNES VOL 6 PG 138 REPLACED 1"X6" IP WITH ALUM. MON.
- 1986 BARNES TOWNSHIP PROJECT FIELD NOTES FROM STA 181.
 FD ALUM. N1-D5-16W 2656.88 TO NE COR SEC 21, SO-44-33E
 2656.18 TO SE COR SEC 21, N89-14-22W 5,288.51 TO W 1/4
 COR SEC 21, 2,651.75 TO INTERSECTION OF 1/4 LINES OF SEC
 21, N89-49-53E 2613.98 TO INTERSECTION OF 1/4 LINES OF
 SEC 22, & 5,252.47 TO E 1/4 COR SEC 22.
- 1987 BARNES BK 2 PG 8 FD ALUM. 0.4' DEEP. SET 1/2X24"
 REROD 40.64 TO THE SE. FD REC PIPE TO THE NORTH,
 WEST, AND EAST. WEST OF CENTER OF GRAVEL DR.
- 1987 BARNES P-13 ALUM. 0.5' DEEP. FD REC PIPE WEST, EAST, NE. SET REROD TO THE SE. FB 2 PG 8, FB 1 PG 7 & 33.
- 1997 LATHROP MAP #8658 ALUM. MON IN DIFFERENT LOCATION THAN IRON PIN THAT WAS USED IN 1960 SURVEY.

FD ALUM. 2.1' DEEP, PIPE TO THE WEST, & REROD TO THE S.E. PLACED 2 MAGNETS ON TOP OF ALUM. MON.

C) Was the corner restored through acceptance of (1) an obliterated evidence location, or, (2) a found perpetuated location?

JA577

D) Describe any material discrepancy between the location of the corner as restored or reestablished and the location of that corner as previously restored or reestablished by distance and direction. Show the discrepancy on the plan view drawing under (a), above. Show the distances between the corner as previously restored or reestablished and (1) the corner as restored or reestablished, and (2) to at least 4 of the witness monuments shown on the drawing in (a), above.

COMBS STATED THEIR RECORDS INDICATED THE CORNER THEY USED IN THE 1980 SURVEY WAS ABOUT 2.5' EAST OF THE ALUM. MON. THIS APPEARS TO BE IN HARMONY WITH THE 1997 LATHROP SURVEY STATEMENT. SINCE IN 1975 SCHROEDER DUG TO A DEPTH OF 4' & FOUND LEE'S 1881 STAKE & HARD HEAD STONES I ACCEPTED THAT LOCATION. ALSO THOM STATED IN HIS 1964 SURVEY, MAP #5654, THE 1/4 COR ACCORDING TO OCCUPATION. SINCE HE DID NOT FIND RECORD EVIDENCE AND SCHROEDER DID NOT FIND HIS PIN, I DID NOT ACCEPT THIS POSITION

(E) Was the corner reestablished through lost corner proportionate methods? If so, show the method, including the directions and distances to other public land survey corners used as evidence or used for proportioning the corner location.

I, **Donald Barnes**, hereby certify that the corner location as identified by the corner code index was determined by me under my direction and control and that this U.S. Public Land Survey Monument Record is correct and complete to the best of my knowledge and belief.

April 20, 2004

SHEET 2 OF 2