

PUBLIC LAND SURVEY MONUMENT RECORD

For Public Land Survey Corners in the


T. 3 N., R. 12 E.

CORNER CODE INDEX

	1	2	3	4	5	6	7	8	9	10	11	12	13	14	15	16	17	18	19	20	21	22	23	24	25
A																									
B																									
C	6	5	4	3	2																				
D																									
E																									
F																									
G	7	8	9	10	11	12																			
H																									
I																									
J																									
K																									
L	8	17	16	15	14	13																			
M																									
N																									
O																									
P	19	20	21	22	23	24																			
Q																									
R																									
S																									
T	30	29	28	27	26	25																			
U																									
V																									
W																									
X																									
Y	31	32	33	34	35	36																			
Z																									

PLACE MONUMENT SYMBOL (◆) AT PROPER LOCATION ON ABOVE INDEX

EXAMPLE

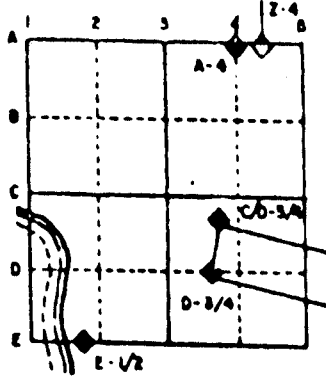

JANESVILLE TWP  
ROCK COUNTY WI

IF AVAILABLE  
STATE PLANE COORDINATES

North (Y) \_\_\_\_\_ Elev. (Z) \_\_\_\_\_  
East (X) \_\_\_\_\_ Zone \_\_\_\_\_  
Hor. Datum \_\_\_\_\_ Vert. Datum \_\_\_\_\_

◆ CORNER MONUMENT

○ WITNESS MONUMENT

BEARINGS ARE BASED ON:

SHEET \_\_\_\_\_ OF \_\_\_\_\_

CORNER CODE: R(11)

(B) Describe any record evidence, monument evidence, occupational evidence, testimonial evidence or any other material evidence you considered, and whether the monument was found or placed.  
FOUND A POLY MONUMENT WITH TOP BROKE OFF.

C) Was the corner restored through acceptance of (1) an obliterated evidence location, or, (2) a found perpetuated location?  
ACCEPTED FOUND MONUMENT OF RECORD. CONSTRUCTION WILL DISTURB AREA.

D) Describe any material discrepancy between the location of the corner as restored or reestablished and the location of that corner as previously restored or reestablished by distance and direction. Show the discrepancy on the plan view drawing under (a), above. Show the distances between the corner as previously restored or reestablished and (1) the corner as restored or reestablished, and (2) to at least 4 of the witness monuments shown on the drawing in (a), above.

(E) Was the corner reestablished through lost corner proportionate methods? If so, show the method, including the directions and distances to other public land survey corners used as evidence or used for proportioning the corner location.  
NO

I, Donald Barnes, hereby certify that the corner points as identified by the corner code index were, in a field survey on, *May 1*, 1994, established, re-established, monumented, re-monumented, recovered or restored as expressed below and in conformance with the regulations and rules as required in the current manual of survey instructions of the United States Department of Interior, Bureau of Land Management.

COUNTY SURVEYOR FILING DATA

Date of computer entry \_\_\_\_\_

Date microfilmed \_\_\_\_\_

Number of included sheets 1  
CORNER CODE

seal  
*Donald Barnes*  
*June 1, 1994*

AFFIX YOUR LAND SURVEYOR SEAL

*R1(1)*

MAST

N44-52-43E

STH 184

80

CRAB TREE

FD PIPE

24

N22-46-26E 85.74  
REC 85.74

S55-39-59E 68.29  
REC 68.29

MAPLE TREE

FD G-1 MON

N65-38-04E 98.33  
REC 98.42


CTH "A" FD POLY WITH TOP BROKE OFF

NW COR SEC 30

N18-43-44E 71.40

S18-43-28E 91.19  
REC 91.23

N25-24-36E 140.52

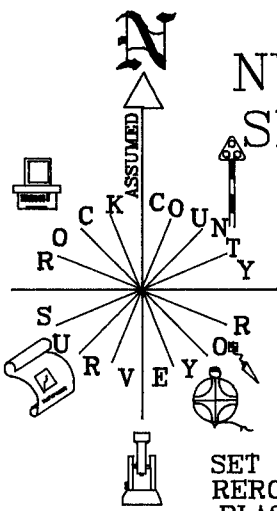

SET 3/4X24 REROD WITH PLASTIC CAP

FIELD BK #3 PG 2

S70-14-52E 55.46

FD PIPE

52

*Donald Barnes*  
June 1, 1994

2 OF 2

R1(1)