
## U.S. PUBLIC LAND SUR MONUMENT RECORD

For Public Land Survey Corners in:

WI ADMINISTRATIVE CODE A-E 7.08 REQUIREMENT

T. 3N., R. /2 E

CORNER CODE INDEX

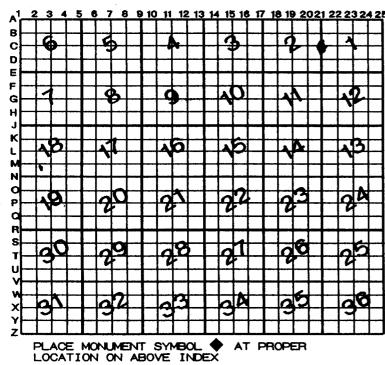

JANE	SVILLE	TWF
ROCK	COUNTY	WI

IF AVAILABLE ROCK COUNTY COORDINATES PERFERRED

North	1 Elev		
East			
Hor.	Datu	m	Vert. Datum
LATI	TUDE	-	ELLIPS. HT
LONG	GITUT	re .	
GPS	(X)		TRAVERSE (X)
BASED	ON	THE	FOLLOWING CONTROL:

**♦**CORNER MONUMENT

WITNESS MONUMENT

BEARINGS ARE BASED ON:

(a)

OBSERVATION SHEET	1 -	
FIELD BOOKPAGE #	SHEET OF	_
SHOW A PLAN VIEW DRAWING DEPICTING THE CORNER MONUMENT A		
PHYSICAL FEATURES, INCLUDING THE EXCAVATION AREA AND DEPTH.		
PLANNING & TONING COMMITTEE ADOPTED THE ABOVE FORM ON 19/9/1099		

## JA519

- (B)Describe any record evidence, monument evidence, occupational evidence, testimonial evidence or any other material evidence you considered, and whether the monument was found or placed.
- 1861 RUGER VOL 1 PG 153 USED THE CORNER TO SUBDIVIDE SECTION 2 BUT STATES NOTHING ABOUT CORNER.
- RUGER VOL 2 PG 20 FOUND STUMPS OF BTY ALSO FOUND HH STONE ON 1870
- LEE VOL 2 PG 93 FOUND STUMP OF N. BT & HH AT CORNER. 1872
- BLEEDHORN VOL 2 PG 438 USED THE CORNER AND REFERS TO PAST PAGES. 1890
- SUNNY VOL 3 PG 446 SET 2X36 PIPE 1939
- BATTERMAN JR. VOL 4 PG 165 SHOWS PK AND REFERENCES SAME. STATES 1963 CORNER IS THE ONE THAT B.JH. SUNNY PLACED.
- BARNES C-21 SET ALUMINUM MONUMENT ACCORDING TO TIES. 1987

FOUND ALUM. MON. WHICH DOES NOT CHECK WITH TIES. MON MAY HAVE BROKEN & THE TOP PLACED WITHOUT VERIFYING THE TIES. THE INTERSECTION LOCATION AS SHOWN ON THE DIAGRAM IS THE LOCATION.

C) Was the corner restored through acceptance of (1) an obliterated evidence location, or, (2) a found perpetuated location?

## ACCEPTED PERPETUATED LOCATION.

- D) Describe any material discrepancy between the location of the corner as restored or reestablished and the location of that corner as previously restored or reestablished by distance and direction. Show the discrepancy on the plan view drawing under (a), above. Show the distances between the corner as previously restored or reestablished and (1) the corner as restored or reestablished, and (2) to at least 4 of the witness monuments shown on the drawing in (a), above.
- (E) Was the corner reestablished through lost corner proportionate methods? If so, show the method, including the directions and distances to other public land survey corners used as evidence or used for proportioning the corner location.

I. Donald Barnes, hereby certify that the corner location as identified by the corner code index was determined by me under my direction and control and that this U.S. Public Land Survey Monument Record is correct and complete to the best of my knowledge and belief.

Seal Sources

faces

emboss

May 6, 1996

Number of included sheets 1

CORNER CODE C-21(1)