Paper weight-110# (minimum)

Black nonfading ink required

U.S. PUBLIC LAND SURVEY MONUMENT RECORD


For Public Land Survey Corners In:

WI ADMINISTRATIVE CODE A-E 7.08 REQUIREMENT

REV 10/23/2004 USMONREC.DWG

T. $\angle N$. R. $\angle O$ E. 4th P.M.

CORNER CODE INDEX

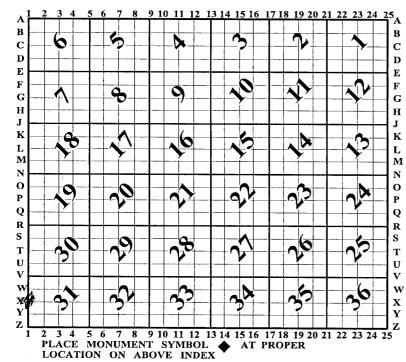

SPRING	VALCO	<u>=</u> ⊁TWl
ROCK C	OUNTV	XX/T

IF AVAILABLE ROCK COUNTY COORDINATES PERFERRED

NorthElev.
East
Hor. Datum Vert. Datum
LATITUDE ELLIPS. HT
LONGITUDE
NAD83(91)NETWORK ADJ. YR
GPS (X) TRAVERSE (X)
BASED ON THE FOLLOWING CONTROL:

♦ CORNER MONUMENT

WITNESS MONUMENT

BEARINGS ARE BASED ON:_____

(a)

FIELD BOOK _____ PAGE # ____ OF ____ OF ____ OF ____ SHOW A PLAN VIEW DRAWING DEPICTING THE CORNER MONUMENT AND SURROUNDING PHYSICAL FEATURES, INCLUDING THE EXCAVATION AREA AND DEPTH.
PLANNING & ZONING COMMITTEE ADOPTED THIS FORM ON 12/2/1982

CORNER CODE X -/(/)

SP614 W1/4CORSEC31

(B) DESCRIBE ANY RECORD EVIDENCE, MONUMENT EVIDENCE, OCCUPATIONAL EVIDENCE, TESTIMONIAL EVIDENCE OR ANY OTHER MATERIAL EVIDENCE YOU CONSIDERED, AND WHETHER THE MONUMENT WAS FOUND OR PLACED.

1833 (APR/MAY) HARRISON NORTH ON THE EAST SIDE OF SEC 36-1ST

MILE <u>T1N R8E</u> NORTHWEST TERRITORY

2640 SET A POST & RAISED A MOUND FOR COR TO 1/4 SEC IN GROUND SLOPING NORTH TO A RAVINE BEARING N.W.

3300 TO THE RANDOM STATE LINE

5280 SEC POST & RAISED A MOUND FOR COR. TO SECS 25 & 36 OF T1N RBE IN GROUND SLOPING NW. VAR 8-25E EAST

1833 (APR/MAY) HARRISON NORTH ON THE EAST SIDE OF SEC 36-1ST
MILE TIN R9E NORTHWEST TERRITORY

198.0 LEAVE TIMBER & ENTER MARSH

2640.0 SET A POST FOR COR TO 1/4 SECTION ON A SMALL ISLAND OF WILLOWS

4290.0 LEFT MARSH

5280.0 SET A POST FOR COR TO SECS 25 & 36 FOR WH A BURR OAK 12 BEARS N57W 42.90' & A BURR OAK 18 INCHES BEARS S25W 361.02'

LAND LEVEL & WET 3RD RATE TIMBER: RED DAK & BURR DAK UNDG. WD(BUSHES) GRUBS & GRASS VAR 8-D E WRITTEN ON LOWER LEFT OF PAGE.

1833 (APR/MAY) HARRISON

NORTH ON E. SIDE OF SEC 25 2ND

MILE TIN R9E

990.0 ENTER MARSH

2640.0 SET A POST FOR COR TO 1/4 SEC IN MARSH
IMPRACTICABLE TO ESTAB. COR. WATER DEEP & TIMBER
DISTANT

3432 LEFT MARSH

5115 ENTER BOTTOM OF SUGAR CREEK

SET POST FOR COR TO SEC 24 & 25 ON WEST EDGE OF BOTTOM TO WH. A RED OAK 12 INCHES BEARS S19W 19.8' OR 198.66' AND A BURR OAK 12 INCHES BEARS N26W 2.97'. LAND ETC-SAME AS LAST MILE

1833 (APR/MAY) HARRISON NORTH ON THE EAST SIDE OF SEC 24-3RD

MILE T1N R9E NORTHWEST TERRITORY

2640.0 SET A POST & RAISED A MOUND FOR COR TO 1/4 SEC IN BOTTOM OF CREEK

5280.0 SET A POST FOR COR TO SECS 13 & 24 POST & RAISED MOUND. LAND LEVEL & PARTIALLY WET 2ND RATE.

THE GROWTH IN THE BOTTOM OF THE CREEK WHERE IT IS NOT TOO WET IS A HIGH GRASS WELL ADAPTED FOR CUTTING HAY AND PASTURING

1833 (APR/MAY) HARRISON NORTH ON THE EAST SIDE OF SEC 13-4RD

MILE TIN R9E NORTHWEST TERRITORY

2211.0 INT. SUGAR CREEK CRS E AND SET A POST FOR MEANDERING CORNER. FROM WHICH A RED OAK 18 INCHES IN DIAM. BEARS S66E 206.58' DIST. LAND ETC. SAME

1833 MULLETT (SEP 2ND) VARIATION 8-0 EAST. BEGUN AT POST ON RIGHT BANK OF SUGAR CREEK, EAST SIDE OF SECTION 13.

EAST SIDE OF TOWNSHIP NO. 1 NORTH RANGE NO. 9 EAST, 4TH MERIDIAN M.T.

NORTH ON EAST SIDE OF SEC 13.

2211.0 FROM CORNER TO SECTIONS 13 & 24

Vnolskanes 3/)4/08 SHEET 1 OF 4
CORNER CODE X-1(1)

2424.84 SET POST ON LEFT BANK SUGAR CREEK. W. ASH 6 S23E DISK 55.44 BUR OAK 14 N48W 237.60

2640.0 SET 1/4 SECTION POST BUR DAK 16 NB 1/2W 63.36 NO OTHER.

3052.50 BUR OAK 12

4620.0 ENTER PRAIRIE

5280 SET OAK POST FOR CORNER TO SECTIONS 12 & 13
RAISED A MOUND, LAND LEVEL 2ND RATE. FIRST PART
THINLY TIMBERED WITH BUR OAK.

1833 MULLETT (SEP 2ND) EAST SIDE OF TOWNSHIP NO. 1 NORTH RANGE NO. 9 EAST, 4TH MERIDIAN M.T.

NORTH ON EAST SIDE OF SEC 12.

2640.00 SET POST FOR 1/4 SECTION CORNER IN (RAISED) A MOUND

5280 SET POST FOR CONRER TO SECTIONS 1 & 12. RAISED A
MOUND OF EARTH COVERED WITH SODS 3 FEET SQUARE
AND 3 FEET HIGH. LAND LEVEL 2ND RATE DRY PRAIRIE

1833 MULLETT (SEP 2ND) EAST SIDE OF TOWNSHIP NO. 1 NORTH. RANGE 9 EAST, 4TH MER. M.T. NORTH ON EAST SIDE OF SEC 1.

2640 SET POST FOR 1/4 SEC CORNER RAISED A MOUND

8826.84 INTERSECTED SOUTH BOUNDARY OF T2 R9E AS RUN OUT FROM POST ON RIGHT BANK OF SUGAR CREEK. SET POST AT INTERSECTION FOR CORNER TO TOWNSHIPS 1 & 2 NORTH OF RANGE 9 EAST. RAISED A MOUND OF EARTH 4 FEET SQUARE AND 4 FEET HIGH. LAND LEVEL SECOND RATE PRAIRIE.

1833 MULLETT (SEP 2ND) NORTH ON EAST SIDE OF SECTION 36 T2N R9E

VARIATION 8-15 EAST NORTH ON EAST SIDE OF SEC

36

2640 SET DAK POST FOR 1/4 SEC CORNER IN PRIARIE RAISED A MOUND.

2970.0 LEAVE PRAIRIE

3156.12 A BUR DAK 12 IN DIAMETER.

5280.0 SET POST FOR CORNER TO SECTIONS 25 & 36. BUR OAK 16 N12W 30.36' BUR OAK 18 S40W 69.96' LAND LEVEL, 2ND RATE, THINLY TIMBERED WITH BUR OAK. FIRST 1/2 PRAIRIE

1833 (SEP 7) MULLETT SOUTH BOUNDARY OF TOWNSHIP NO. 2
NORTH, RANGE 10E, 4TH MERIDIAN M.T.
WEST ON SOUTH SIDE SECTION 31

1056.0 ENTER MARSH

2640.00 SET QUARTER SEC POST BLACK OAK NORTH 44.88' NO OTHER

3300.00 STREAM 9.9' SOUTH

3960.00 LEAVE MARSH AND ENTER PRAIRIE.

5280.00 INTERSECTED RANGE LINE 4117.08' SOUTH OF POST.
SET POST AT INTERSECTION FOR CORNERS TO
TOWNSHIP 1 & 2 RANGE 9 & 10E. MADE A MOUND OF
EARTH AND SODS 4 FEET DIAMETER AT BASE 3 FEET
HIGH. LAND MARSHY. SEPT 7TH 1833
[PLAT CALLS FOR 4117.08 FROM SW COR SEC 31 TO NE
COR SEC 1 OF T1N R9E & 2071.74 FROM W 1/4 COR SEC
6 TO NW COR SEC 6 T1N R10E.]

1834 (MARCH 16) MILLER WEST RANDOM BETWEEN SECS 30 & 31
2970 ENTER CREEK BOTTOM

3128.40 CREEK 13.2' @ S.W.

SHEET 2 OF 4

CORNER CODE X-1(1)

Dural Barnes 3/14/08 SP614

3630 LEAVE CREEK BOTTOM ENTER PRAIRIE

5553.9 INTERSECTED RANGE LINE 11.74' N DR 1173.48' DF POST LAND LEVEL 2ND RATE DAK

WEST (SHOULD PROBABLY BE EAST)
CORRECTED BETWEEN SECS 30 TO 31

2913.9 1/4 SEC COR. A YELLOW DAK 6 IN DIA.

4511.10 BURR DAK 15 IN

5553.90 SEC COR.

- 1874 RUGER VOL 2 PG 131 DROVE STAKE SURROUNDED IT BY 4
 LIMESTONES. SAID STAKE IS 24.75' EAST OF FENCE ON W. SIDE OF
 ROAD. & 7.92' N. OF FENCE ON S. SIDE OF ROAD RUNNING EAST.
 VAR 6-47 2627.13 TO FD LS @ SW COR SEC 31 & VAR 6-47 2627.13
 TO FD COR EST BY LEE-LS 26X18X3 @ NW COR SEC 31. FD STAKE &
 LIMESTONE BESIDE IT AT TOWN COR FOR GREEN COUNTY (NE COR
 SEC 1). NE COR SEC 1 IS 4132.26 NORTH OF SW COR SEC 31. VAR
 3-39 2774.97 TO DROVE STAKE SURROUNDED BY 4 LS @ CENTER
 OF SEC 31.
- 1937 SUNNY VOL 3 PG 355 DUG 4X6X3.5 DEEP HOLE. FOUND NO MONUMENT SET BY RUGER 1879
- 1963 BATTERMAN JR. VOL 4 PG 160 DUG LARGE HOLE AT THE W 1/4 COR OF SEC 31-2-10 & FOUND NOTHING.
- 1963 COMBS CSM VOL 1 PG 327 CALLS FOR THE WEST LINE OF SEC 31 AS A STRAIGHT LINE WITH A FD LIMESTONE AS SET BY RUGER @ THE NW COR OF SEC 31 AND A FD LIMESTONE AS SET BY RUGER @ THE SW COR OF SEC 31. 1314.16 FROM THE SW COR SEC 31 TO THE NW COR OF CSM LOT.
- 1970 BATTERMAN JR VOL 4 PG 441 FD 4 LIMESTONES. SET 1" PIPE & MON. BOX. REFERENCED SAME. PENCELED IN "TO BE CHANGED-CORNER SET 3-3 W. OF MON. BOX."
- 1970 BATTERMAN JR. VOL 4 PG 441 BELOIT SET. SAME AS ABOVE EXCEPT COMBS & THOM ADDED TO PENCELED NOTE.
- 1977 TALARCZYK GREEN COUNTY TIE SHEET FOR THE NE COR SEC 1 T1N RO9E. SET BY PROPORTIONATE MEASUREMENT & EXISTING PHYSICAL EVIDENCE. SHOWS AS IN NORTH BOUND LANE.
- 1976 BARNES VOL 5 PG 146 APR 28 SET BERNTSON W-1-8 MON. FD PIPE 6.2 WEST OF FD MON. BOX. REFERENCED SAME. INFORMED MR. H. LEE OF FIELD RESULTS. HE AGREED TO THE RESETING OF THE W 1/4 COR SEC 31. FIELD NOTES FROM BK 152 PG 45 & CSM VOL 1 PG 327 STATED NOTHING WAS FOUND. VOL 4 PG 131 COUNTY SURVEYOR RECORDS ERRONEOUSLY STATED RECORD STONES WERE FOUND.
- 1976 BARNES VOL 5 PG 147 2629.40 TO NW COR SEC 31, 2629.20 TO SW COR SEC 31, 2903.3 FROM NW COR SEC 31 TO N1/4 COR SEC 31.
- 1978 BARNES VOL 5 PG 476 FD ALUM MON @ W 1/4 COR SEC 31.
 2629.40 TO NW COR SEC 31, 2629.30 TO SW COR SEC 31 4135.62
 FROM SW COR SEC 31 TO FD ALUM. @ NE COR SEC 1.
- 1982 BARNES VOL 6 PG 242 SW COR SEC 31 TO E 1/4 COR SEC 1 T1N R9E IS 1643.36
- 1995 TALARCZYK #09394 CAST IRON @ W 1/4 COR SEC 31. 5461.73 TO E 1/4 COR SEC 31.
- 2000 BRADSHAW CSM VOL 24 PG 28 STATES FD BUT NOT THE TYPE OF MON HE FD. NOO-34-40W 2628.76 TO NW COR SEC 31, EAST 2775.38 TO CENTER OF SEC 31, EAST 5460.96 TO E 1/4 COR SEC 31, ANGLE 90-01-05 @ NW COR SEC 31 FROM N 1/4 COR SEC 31 TO W 1/4 COR SEC 31, EAST 2685.58 FROM CENTER OF SEC 31 TO E SHEET 3 OF 4

CORNER CODE X-1(1)

July Barres 3/14/08 1/4 COR SEC 31, & ANGLE 90-34-40 @ W 1/4 COR SEC 31 FROM NW COR SEC 31 TO E 1/4 COR SEC 31.

- 2002 NIPPLE #14362 FD ALUM. MON. NORTH 2629.32 TO FD 1" PIPE IN MON. BOX & ANGLE 90-01-10 @ NW COR SEC 31 FROM N 1/4 COR SEC 31 TO W 1/4 COR SEC 31.
- 2002 NIPPLE X-1 FD (4) FOUR ROUND MAGNETS AT 1 TO 2 FEET DEEP.
 REPLACED THE MAGNETS AND SET A 3/4X24" IRON ROD. FOUND
 PERPETUATED LOCATION. REFERENCED SAME. 2629.32 TO FD 1"
 IRON PIPE IN SQUARED MONUMENT BOX 3" BELOW PAVED SURFACE
 REPAIRED PAVEMENT AND REPLACED PK FOR REFERENCE AT NW
 COR SEC 31. FD NW, SW, & SE REFENCE PIPE AS SET 1976 BY
 BARNES IN VOL 5 PG 146. 48.06 (REC 48.06) FROM THE SET ROD
 TO THE FD SW REF. PIPE, 42.27 (REC 42.08) TO THE FD NW REF
 PIPE, 48.77 (REC 48.77) TO THE FD SE REF. PIPE, & 67.91 (REC
 67.49) FROM THE SW TO NW REF. PIPE.
- 2004 BRADSHAW CSM VOL 27 PG 299 FD IRON ROD IN PVMT. NOD-01-16E 2629.32 TO NW COR SEC 31, S89-24-58E 2776.07 TO CENTER OF SEC 31, S89-24-58E 5461.52 TO E 1/4 COR SEC 31, ANGLE 90-01-16 @ NW COR SEC 31 FROM N 1/4 COR SEC 31 TO W 1/4 COR SEC 31, FROM CENTER OF SEC 31 TO E 1/4 COR SEC 31 IS S89-24-58E 2685.45, & ANGLE 90-33-46 @ W 1/4 COR SEC 31 FROM NW COR SEC 31 TO E 1/4 COR SEC 31.
- C) WAS THE CORNER RESTORED THROUGH ACCEPTANCE OF (1) AN OBLITERATED EVIDENCE LOCATION, OR, (2) A FOUND PERPETUATED LOCATION?

ORIGINAL GOVERNMENT SURVEYOR DID NOT ESTABLISH THE W 1/4 COR OF SEC 31. A PRIVATE SURVEYOR QUESTIONED THE FD MONUMENTS, SO I CONSTRUCTED THE HISTORY OF THE CORNER FOR THE SAKE OF CLARITY.

- D) DESCRIBE ANY MATERIAL DISCREPANCY BETWEEN THE LOCATION OF THE CORNER AS RESTORED OR REESTABLISHED AND THE LOCATION OF THAT CORNER AS PREVIOUSLY RESTORED OR REESTABLISHED BY DISTANCE AND DIRECTION. SHOW THE DISCREPANCY ON THE PLAN VIEW DRAWING UNDER (A), ABOVE. SHOW THE DISTANCES BETWEEN THE CORNER AS PREVIOUSLY RESTORED OR REESTABLISHED AND (1) THE CORNER AS RESTORED OR REESTABLISHED, AND (2) TO AT LEAST 4 OF THE WITNESS MONUMENTS SHOWN ON THE DRAWING IN (A), ABOVE.
- (E) WAS THE CORNER REESTABLISHED THROUGH LOST CORNER PROPORTIONATE METHODS? IF SO, SHOW THE METHOD, INCLUDING THE DIRECTIONS AND DISTANCES TO OTHER PUBLIC LAND SURVEY CORNERS USED AS EVIDENCE OR USED FOR PROPORTIONING THE CORNER LOCATION.
- I, Donald Barnes, hereby certify that the corner location as identified by the corner code index was determined by me under by direction and control and that this U.S. Public Land Survey Monument Record is correct and complete to the best of my knowledge and belief.

3=u1

SHEET 4 OF 4

CORNER CODE X-1(1)

A-E 7.08 REQUIREMENT