U.S.


ROCK COUNTY PROJECTION


BEARINGS ARE BASED ON: ___

PUBLIC LAND SURVEY MONUMENT RECORD

		5.T				WI ADMINISTRATIVE CODE A-E 7.08 REQUIREMENT REV 10/23/2004 USMONREC.DWG
					l.	0 51 5
3 4 5					1 22 23 24	BELCIT TWP
						ROCK COUNTY WI
					7	D IF AVAILABLE
-				+		ROCK COUNTY COORDINATES PERFERRED
A	9	9	10	N)	10	F G
						H North Elev
8	~^	16	15	200	13	K East
>	-	7	 		-	M Hor. Datum Vert. Datum
			0	- 0	N	0
\ 7	70	77	9,1	7	2	P LATITUDE ELLIPS. HT
				6	6	R S LONGITUDE
30	7	20	2	20	2	T
						U NAD83(91)NETWORK ADJ. YR 2010
3	3	3	20	35	36	x GPS (X) TRAVERSE (X) X
	11	Hi				z based on the following control:
2 3 4 5	6 7 8	9 10 11 12	3 14 15 16 1	7 18 19 20	1 22 23 24	25 BASED ON THE POLLOWING CONTROL.
				ROPER		
	A (CORNER	MONUN	MENT		WITNESS MONUMENT
	•	JOIN LIN	1/101/01	,,,,,,,,,,,,,,,,,,,,,,,,,,,,,,,,,,,,,,,		
T						
i						
	3 4 5 0	T	TN. R CORNER C 2 3 4 5 6 7 8 9 10 11 12 1 6 9 9 9 9 9 9 9 9 9 9 9 9 9 9 9 9 9 9	TN. RZE. 4 CORNER CODE INI 2 3 4 5 6 7 8 9 10 11 12 13 14 15 16 1 3 4 5 6 7 8 9 10 11 12 13 14 15 16 1 PLACE MONUMENT SYMBOL AT PLOCATION ON ABOVE INDEX CORNER MONUMENT	TN. RZE. 4th P.M. CORNER CODE INDEX 2 3 4 5 6 7 8 9 10 11 12 13 14 15 16 17 18 19 20 2 2 3 4 5 6 7 8 9 10 11 12 13 14 15 16 17 18 19 20 2 PLACE MONUMENT SYMBOL	T/N. R/ZE. 4th P.M. CORNER CODE INDEX 2 3 4 O

es i				
FIELD BOOK PAGE #			-/	
OR OBSERVATION SHEET		SHEET	OF	\supset
SHOW A PLAN VIEW DRAWING DEPICTING THE CORNER M		SURROUNI	DING	
PHYSICAL FEATURES, INCLUDING THE EXCAVATION ARE				
PLANNING & ZONING COMMITTEE ADOPTED THIS FORM ON 1				()
	CORNER	CODE .	2-21	(2)

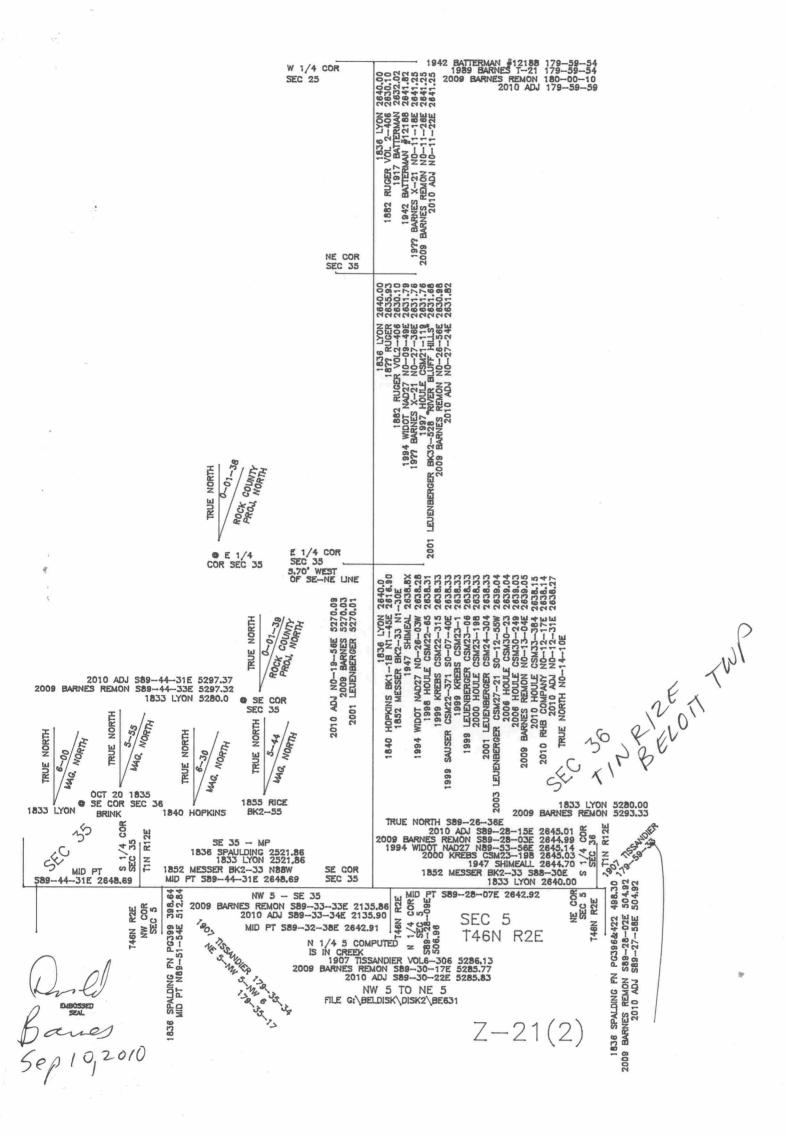

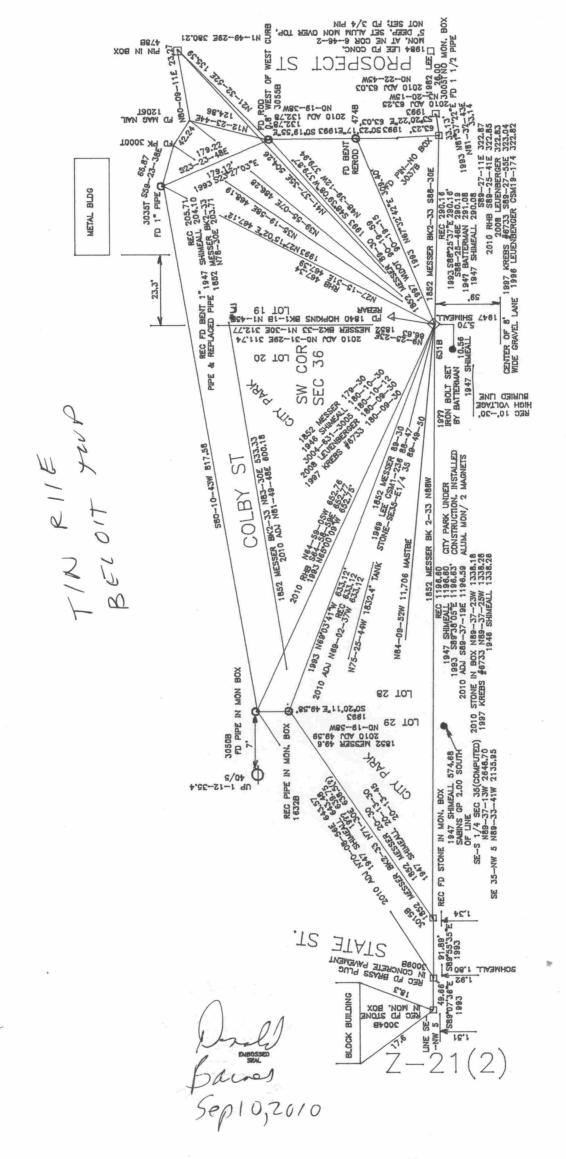

40F5

- BE631 SWCORSEC36
- 2003 LEUENBERGER CSM 27-24 COMPUTED FROM COUNTY TIES 2639.04 TO W 1/4 COR SEC 36.
- 2003 HOULE CSM 30-23 COMPUTED FROM COUNTY TIES 2639.04 TO W 1/4 COR SEC 36.
- 2006 HOULE CSM 30-249 COMPUTED FROM COUNTY TIES 2639.03 TO W 1/4 COR SEC 36.
- 2008 LEUENBERGER #15255 @ SW COR SEC 36 COORDINATES FROM COUNTY SURVEYOR TIES. S89-27-55E 322.83 TO FD PIPE. N89-37-25W 763.77 TO FD 1" PIPE WHICH IS 1.31' SOUTH & 0.03' W OF PIPE ON STATE LINE. ANGLE 180-09-30 @ SW COR SEC 36 FROM THE WEST TO THE EAST.
- 2010 HOULE CSM 33-384 COMPUTED FROM COUNTY TIES. 2638.15 TO FD BASE OF POLY WITH CAP MISSING @ W 1/4 COR SEC 36.
- Was the corner restored through acceptance of (1) an obliterated evidence location, or, (2) a found perpetuated location?

ACCEPTED PERPETUATED LOCATION. SET ALUM. MON.

Describe any material discrepancy between the location of the corner as restored or reestablished and the location of that corner as previously restored or reestablished by distance and direction. Show the discrepancy on the plan view drawing under (a), above. Show the distances between the corner as previously restored or reestablished and (1) the corner as restored or reestablished, and (2) to at least 4 of the witness monuments shown on the drawing in (a), above.

1946 SHIMEALL (Z-21) FD A BROKEN LIMESTONE 2"X25"X1.5" IN NATURAL GROUND, WHICH WAS 8.5' BELOW SURFACE OF GROUND. HE SET A 1"X8" ROD & MONUMENT COVER OVER CENTER OF PILE. HE NOTED ON THE SURVEY THE STONE WAS 10.56' EAST & 5.70' NORTH OF THE IRON BOLT SET BY BATTERMAN. BATTERMAN SET THE BOLT FROM TIES TAKEN BY MC ALLEN, A SURVEYOR IN SOUTH BELOIT IN ABOUT 1910.

Was the corner reestablished through lost corner proportionate methods? If so, show the method, including the directions and distances to other public land survey corners used as evidence or used for proportioning the corner location.

NO

I, **Donald Barnes**, hereby certify that the corner location as identified by the corner code index was determined by me under my direction and control and that this U.S. Public Land Survey Monument Record is correct and complete to the best of my knowledge and belief.

Emboss Sep 10, 2010

SHEET 3 OF 5

CORNER CODE Z-3/(2)

A.E. 7.08 REQUIREMENT

BE6 WCORSEC36

- 1947 SHIMEALL CITY OF BELOIT NOTES CALLS FOR CORNER BUT STATES NOTHING ABOUT IT. CALLS FOR 2638.80 TO W 1/4 COR SEC 36, 607.3 TO NORTH PROPERTY LINE OF ST PAUL ST., & 868.3 TO SOUTH PROPERTY LINE OF BROAD ST.
- 1968 LEE CSM 1-161 1" IRON B' LONG SET IN MON. BOX N88-00W 1236.27' TO DRILL HOLE IN CONC. ON EAST SIDE OF STATE RD.
- 1969 LEE CSM VOL 1 PG 236 STATES NOTHING ABOUT MON. S88-30-00E 1268.16 ALONG STATE LINE; THENCE NO-17-00E 344.88 TO COLBY
- 1982 BARNES Z-21 CORNER IS IN SALVAGE YARD. DUG 12' TO NATURAL GROUND AND 2' BELOW NATURAL GROUND AND FOUND NOTHING. IN 1946 SHIMEAL FOUND A BROKEN LIMESTONE 2' X 25" X 1.5" IN NATURAL GROUND WHICH WAS 8.5' BELOW SURFACE OF GROUND. HE SET A 1"X8' ROD. I SET THE CORNER USING THE BEARINGS AND DISTANCES FROM SCHIMEAL'S MONUMENTS. NOTHING WAS SET BECAUSE OF THE SALVAGE OPERATION. THE DISTANCE TO THE S 1/4 COR OF SEC 36 (2644.70 REC) IS IN HARMONY WITH THE ORIGINAL.
- 1982 LEE #13846 SET. SET 5/8" PIN 31.00 EAST OF SET 5/8 PIN ON WEST R/W LINE. 26.00 EAST OF EAST R/W LINE IS NE 6 46-2. AT NE COR FD CONC. MON 5' DEEP. SET ALUM. MON. OVER TOP.
- 1983 LEUENBERGER CSM 11-266 ROCK COUNTY TIES N89-56-OOW 1062.75 TO PROPERTY COR.
- 1984 BARNES #6089 MYLAR COPY OF SHIMEAL'S 1946 DATA ON GOODHUES SUB. & MY DISTANCES & BEARINGS. STATEMENT: THE FOLLOWING SURVEY IS OF THE STATE LINE. THE MONUMENTS SHOWN WERE USED TO ESTABLISH THE SW CORNER OF SEC 36 BELOIT TWP T1R R12E. SHIMEALL'S DISTANCES WERE COPIED FROM A SURVEY HE DID IN MAY 1941. THE SURVEY IS FILED IN THE GOODHUES SUB AT THE CITY HALL.
- 1992 BARNES Z-21(1) FOUND REFERENCE TIES. PERPETUATED LOCATION.
- 1996 LEUENBERGER CSM 19-174 LOCATION DETERMINED FROM SEC COR TIES PROVIDED BY COUNTY SURVEYOR'S OFFICE. CORNER FALLS IN SCRAP METAL PILE. NOTHING FD OR SET.
- 1997 KREBS #6733 IN SCRAP PILE; COORDINATE FROM ROCK COUNTY SURVEYOR. S89-27-55E 257.03 TO PIN SET 2' SOUTH OF COR FENCE IS 0.9' N OF PIN, S89-27-55E 286.82 TO PIN SET, 323.04 TO FD PIN MON BOX @ CENTER WHEELER AVE. 5.29 SOUTH OF STATE LINE.
- 1997 DOT #25541, 25440,25438, & 25439 NAD 27 182,347.30; 2,261,164.25. FROM COUNTY TIES. N89-53-56E 2645.14 TO S 1/4 COR SEC 36 & NO-26-03W 2638.28 TO POLY @ E 1/4 COR SEC 35.
- 1998 HOULE CSM 22-65 LOCATION DETERMINED FROM SEC COR TIES PROVIDED BY COUNTY SURVEYOR'S OFFICE. 2638.31 TO E 1/4 COR SEC 35
- 1999 KREBS CSM 22-315 COR FROM COUNTY TIES. 2638.33 TO FD ALUM @ W 1/4 COR SEC 36.
- 1999 SAUSER CSM 22-371 FROM COUNTY TIES. 2638.33 TO W 1/4 COR SEC 36.
- 1999 LEUENBERGER CSM 22-410 LOCATION DETERMINED FROM SEC COR TIES PROVIDED BY COUNTY SURVEYOR'S OFFICE. 2638.33 TO W 1/4 COR SEC 36.
- 1999 KREBS CSM 23-1 FROM COUNTY TIES 2638.33 TO W 1/4 COR SEC
- 2000 KREBS CSM 23-185 FROM COUNTY TIES 2645.03 TO ALUM @ S 1/4 COR SEC 36.
- 2000 HOULE CSM 23-198 COMPUTED FROM COUNTY TIES 2638.33 TO W 1/4 COR SEC 36.
- 2001 LEUENBERGER CSM 24-304 COMPUTED FROM COUNTY TIES 2638.33 TO W 1/4 COR SEC 36.
- 2003 LEUENBERGER CSM 27-21 COMPUTED FROM COUNTY TIES 2639.04 TO W 1/4 COR SEC 36. 21

IKE

CORNER CODE Z-13(2) SHEET 2 OF 5

10

1833 LYON BASE LINE (N.W. TERR) VAR 6-DDE EAST ALONG THE SOUTH SIDE OF SEC 35.

> TO A WHITE ASH 6 INCHES DIAMETER ON THE RIGHT ON WEST BANK OF ROCK RIVER, FRACTIONAL CORNER TO SEC 35. A RED CEDAR STANDS NEAR BY ON THE UP STREAM SIDE OF SAID ASH, AND THREE OTHERS STAND NEAR BY BELOW.

2640 1/4 SEC. CORNER IN THE RIVER, WHICH RUNS SOUTH.

2758.14 TO A LARGE HEWN POST ON THE LEFT BANK OF RIVER. BUR OAK 20 N6E 20', ELM 18 S12W 18'.

5280 SET POST IN A PIECE OF BOTTOM PRAIRIE FOR CORNER TO SECTIONS 35 & 36 BUR DAK 20 N25W 364', BLACK DAK 12 N21E 387'. WEST SIDE OF RIVER 2ND RATE PRAIRIE, EAST SIDE TIMBERED BOTTOM LAND 1ST RATE.

1836 LYON - ORSON (COPY) OF THE FIELD NOTES OF FRACTIONAL TOWNSHIP NO 1 NORTH IN RANGE 12 EAST OF THE 4TH PRINCIPAL MERIDIAN NORTH BETWEEN SECTIONS 35 & 36 VAR 5-55E

> 343.86 **B. OAK 12 INCHES DIAMETER** 1188 WHITE DAK 9 INCHES DIAMETER 2475 INDIAN TRAIL LEADING NE & SW

2640 SET QUARTER SECTION POST {WHITE OAK 32 S25E 21.12' BUR OAK 9 N50-30E 14.52'

4163.94 WHITE OAK 30 INCHES DIAMETER

SET POST CORNER TO SECTIONS 25,26,35,& 5280 36{WHITE DAK 26 S18W 23.76' WHITE DAK 22 N4D-30E 44.88'. FIRST 1980' LEVEL & FIRST RATE LAST 3300' HILLY & 2ND RATE TIMBER WHITE BLACK & BUR DAK. UNDER GROWTH SAME WITH GRASS & RED ROOT.

1840 HOPKINS BK 1 PG 18 "HOPKIN'S SURVEY OF BELOIT" VAR 6-30 STATES NOTHING ABOUT MON. N1-45"E 2616.90 TO THE W 1/4 COR SEC 36. 528.66 TO SOUTH SIDE OF RACE ST.

1852 MESSER "GOODHUES SUB OF BLOCKS IN THE VILLAGE OF BELOIT "BK 2 PG 33 MERIDIAN ADOPTED BY JOHN HOPKINS, DISTRICT SURVEYOR. STATES NOTHING ABOUT MONUMENT. CALLS FOR IT AS THE LOT CORNER BETWEEN LOT 19 & 20. THE BEARING OF THE SECTION LINES IS S88-30E, N88W, & THE LINE BETWEEN LOTS 19 & 20 IS N1-30E. ALSO ONE OF THE LOT DISTANCES IS NON READABLE SO I AM UNABLE TO DETERMINE THE DISTANCE BETWEEN THE SECTION CORNER & THE MONUMENT THAT WAS PLACED TO THE WEST.

1855 RICE "PLAT OF TOWN OF BELOIT" BK 2 PG 55 VAR OBSERVED 5-44 EAST. THE STATE LINE BEING EAST & WEST RFERENCE FOR THE DIRECTION OF THE STATE STONE BEING LAID TO THE US POST ON THE BANK OF ROCK RIVER & SE COR THE TOWNSHIP (B) DENOTES BLOCK ON SQUARE """. WESTERLY 1244 TO EAST ROAD R/W

1910 ALLEN Z-21) SET TIES.

19?? BATTERMAN SHIMEALL'S SURVEY CALLS FOR BATTERMAN SETTING AN IRON BOLT.

1946 SHIMEALL (Z-21) FD A BROKEN LIMESTONE 2"X25"X1.5" IN NATURAL GROUND, WHICH WAS 8.5' BELOW SURFACE OF GROUND. HE SET A 1"X8' ROD & MONUMENT COVER OVER CENTER OF PILE. HE NOTED ON THE SURVEY THE STONE WAS 10.56' EAST & 5.70' NORTH OF THE IRON BOLT SET BY BATTERMAN. BATTERMAN SET THE BOLT FROM TIES TAKEN FROM Mc ALLEN, A SURVEYOR IN SOUTH BELOIT IN ABOUT 1910.

I KIE E

CORNER CODE Z-1含(2) SHEET 1 OF 5

Sep 10 2010