

Paper weight-110# (minimum)

Black nonfading ink required

# U.S. PUBLIC LAND SURVEY MONUMENT RECORD

For Public Land Survey Corners In:  
T. 1N. R. 12E. 4th P.M.  
CORNER CODE INDEX

WI ADMINISTRATIVE CODE A-E 7.08 REQUIREMENT  
REV 10/23/2004 USMONREC.DWG

BELOIT TWP  
ROCK COUNTY WI

IF AVAILABLE  
ROCK COUNTY COORDINATES PREFERRED

A	1	2	3	4	5	6	7	8	9	10	11	12	13	14	15	16	17	18	19	20	21	22	23	24	25	A
B		6				5				4				3				2			1					B
C																										C
D																										D
E																										E
F																										F
G																										G
H																										H
J																										J
K																										K
L																										L
M																										M
N																										N
O																										O
P																										P
Q																										Q
R																										R
S																										S
T																										T
U																										U
V																										V
W																										W
X																										X
Y																										Y
Z																										Z

North \_\_\_\_\_ Elev. \_\_\_\_\_

East \_\_\_\_\_

Hor. Datum \_\_\_\_\_ Vert. Datum \_\_\_\_\_

LATITUDE \_\_\_\_\_ ELLIPS. HT. \_\_\_\_\_

LONGITUDE \_\_\_\_\_

NAD83(91) \_\_\_\_\_ NETWORK ADJ. YR \_\_\_\_\_

GPS (X) \_\_\_\_\_ TRAVERSE (X) \_\_\_\_\_

BASED ON THE FOLLOWING CONTROL:

◆ CORNER MONUMENT

○ WITNESS MONUMENT

BEARINGS ARE BASED ON: ROCK COUNTY PROJECTION

FIELD BOOK \_\_\_\_\_ PAGE # \_\_\_\_\_  
OR OBSERVATION SHEET \_\_\_\_\_

SHEET 1 OF 3

SHOW A PLAN VIEW DRAWING DEPICTING THE CORNER MONUMENT AND SURROUNDING PHYSICAL FEATURES, INCLUDING THE EXCAVATION AREA AND DEPTH.

PLANNING & ZONING COMMITTEE ADOPTED THIS FORM ON 12/2/1982

CORNER CODE A-251

BE513 NECORSEC1 & TU501 NW SEC 6

(B) Describe any record evidence, monument evidence, occupational evidence, testimonial evidence or any other material evidence you considered, and whether the monument was found or placed.

- 1835 ORIG WEST SOUTH SIDE SECTION 31 T2N R13E INTERSECTED RANGE LINE OF NORTH OF TEMPORARY 6 MILE 447.48'. SET POST AT INTERSECTION CORNER TOWNSHIPS 1&2 T12N & R13E IN PRIRIE IN MOUND 6' SQUARE AND FOUR FEET HIGH. PIT SOUTH OF POST 9.24'.
- 1871 RUGER LA PRAIRIE TWP REMON FIELD NOTES. SOUTH OF WEST LINE OF SW 1/4 OF SEC 31 ON A VAR 6-33 AT 2647.26' INTERSECTED SOUTH BOUNDARY LINE 9.24' WEST OF COR. FOUND REMAINS OF OLD STAKE AT COR. CORRECTED VAR 6-45. SET CUT LIMESTONE. CALLS FOR 2647.26 VAR 6-45 TO W 1/4 COR & 2590.17 VAR 5-10 TO S 1/4 COR SEC 31 LA PRAIRIE TWP.
- 1876 RUGER VOL 2 PG 216 FOUND MONUMENT. SHOWS 2596.11 TO S 1/4 COR SEC 36 & 2641.65' TO E 1/4 COR SEC 36.
- 1881 HOLMES VOL 2 PG 338 FOUND STONE MONUMENT. SHOWS 2646.60 TO W 1/4 COR OF SEC 31 LA PRAIRIE TWP AND 2591.16 TO THE S 1/4 COR OF SEC 31.
- 1893 BLEEDORN VOL 2 PG 480 CALLS FOR A MONUMENT. SHOWS 2649.90 TO THE S 1/4 COR OF SEC 31 LA PRAIRIE TWP.
- 1936 SUNNY VOL 3 PG 296 FOUND 6X6 CUT STONE MON. 43" LOW. SET S 1/2 X3' CONCRETE FENCE POST ON TOP 3'0" LONG. PLACED 1 1/2X7 IRON PIPE MONUMENTT, CAPPED ON TOP FLUSH WITH BLACK TOP PAVEMENT AND REFERENCED SAME.
- 1948 SHIMEALL VOL 6 PG 367 FIELD NOTES PG 61 TRANSCRIBED FIELD NOTES. CALLS FOR 2594 TO N 1/4 COR SEC 1
- 1957 BATTERMAN VOL 3 PG 527 SEE VOL 3 PG 296 2637.97 TO N 1/4 COR SEC 1, 3085.10 TO E 1/4 COR SEC 1, ANGLE 91-36-20 AT NE COR SEC 1 FROM E 1/4 TO N 1/4 CORNERS SEC 1, & ANGLE 179-12 AT E 1/4 COR SEC 1 FROM SE TO NE CORNERS OF SEC 1.
- 1960 BATTERMAN JR. VOL 4 PG 57 STATES NOTHING ABOUT MON. SHOWS REFERENCE TIES.
- 1979 BARNES VOL 5 PG 576 FD MON. BOX. SHOWS THE FOLLOWING DISTANCES: TO N 1/4 COR OF SEC 1
 

NB9-44-36E	2638.43
RUGER	2596.11
BATTERMAN	2637.97
ORIGINAL	2640
- 1984 BARNES VOL 6 PG 316. ALUMINUM MONUMENT. DOT COORDINATES N/S 214,498.03;E/W 2,266,352.37
- 1985 BARNES VOL 6 PG 335 SHOWS THE FOLLOWING DISTANCES:
 

TO E 1/4 COR SEC 36	RUGER	2641.65
S 1/4 COR SEC 36	RUGER	2596.11
	SIMMEALL	2594
- 1986 BARNES Z-1 FD 1" PIPE IN MON BOX @ CENTER OF PVMT. REF SAME.
- 1989 BARNES VOL 6 PG 397 SHOWS THE FOLLOWING DISTANCES: TO E 1/4 COR SEC 36
 

N2-00-30W	2645.08	
RUGER	2641.65	
S 1/4 COR SEC 36	S89-01E	2594.32
	SHIMEALL	2594.23
	RUGER	2596.11
	ORIGINAL	2640
	PLAT	2671.02

*Donald Barnes*  
 Sep 19, 2012

BE513 NECORSEC1 & TU501 NW SEC 6

1995 BARNES A-1 FOUND 1" PIPE IN MON. BOX. ACCEPTED FD  
PERPETUATED LOCATION. N/S 233,159.20; 496,445.58'  
2012 BARNES COUNTY READJUSTMENT N/S 233159.34'; E/W 496,445.40'

FD 1" PIPE IN MON. BOX & REFERENCE TIES. BOX IS ABOUT 0.9' BELOW  
PVMT SURFACE.

C) Was the corner restored through acceptance of (1) an obliterated evidence location, or, (2) a found  
perpetuated location?

ACCEPTED FD PIPE IN BOX.

D) Describe any material discrepancy between the location of the corner as restored or reestablished and the  
location of that corner as previously restored or reestablished by distance and direction. Show the discrepancy on  
the plan view drawing under (a), above. Show the distances between the corner as previously restored or  
reestablished and (1) the corner as restored or reestablished, and (2) to at least 4 of the witness monuments shown  
on the drawing in (a), above.

NONE

(E) Was the corner reestablished through lost corner proportionate methods? If so, show the method, including  
the directions and distances to other public land survey corners used as evidence or used for proportioning the  
corner location.

I, **Donald Barnes**, hereby certify that the corner location as identified by the corner code index was  
determined by me under my direction and control and that this U.S. Public Land Survey Monument  
Record is correct and complete to the best of my knowledge and belief.

*Donald Barnes*

SEAL  
EMBOSS

SHEET 2 OF 3

CORNER CODE A-25(1)

SEP 19, 2012

A.E. 7.08 REQUIREMENT


1936 SUNNY VOL 3 PG 296  
 1960 BATTERMAN VOL 4 PG 57  
 SET 1" PIPE  
 1986 LA PRAIRIE FB#3 PG 25  
 1990 BARNES Z-1  
 1993 TURTLE TWP STA 946  
 1995 BARNES Z-25  
 2012 COMBS

LA PRAIRIE TWP  
 SEC 31

TOWNLINE RD

TURTLE TWP  
 SEC 6

"G" CTH

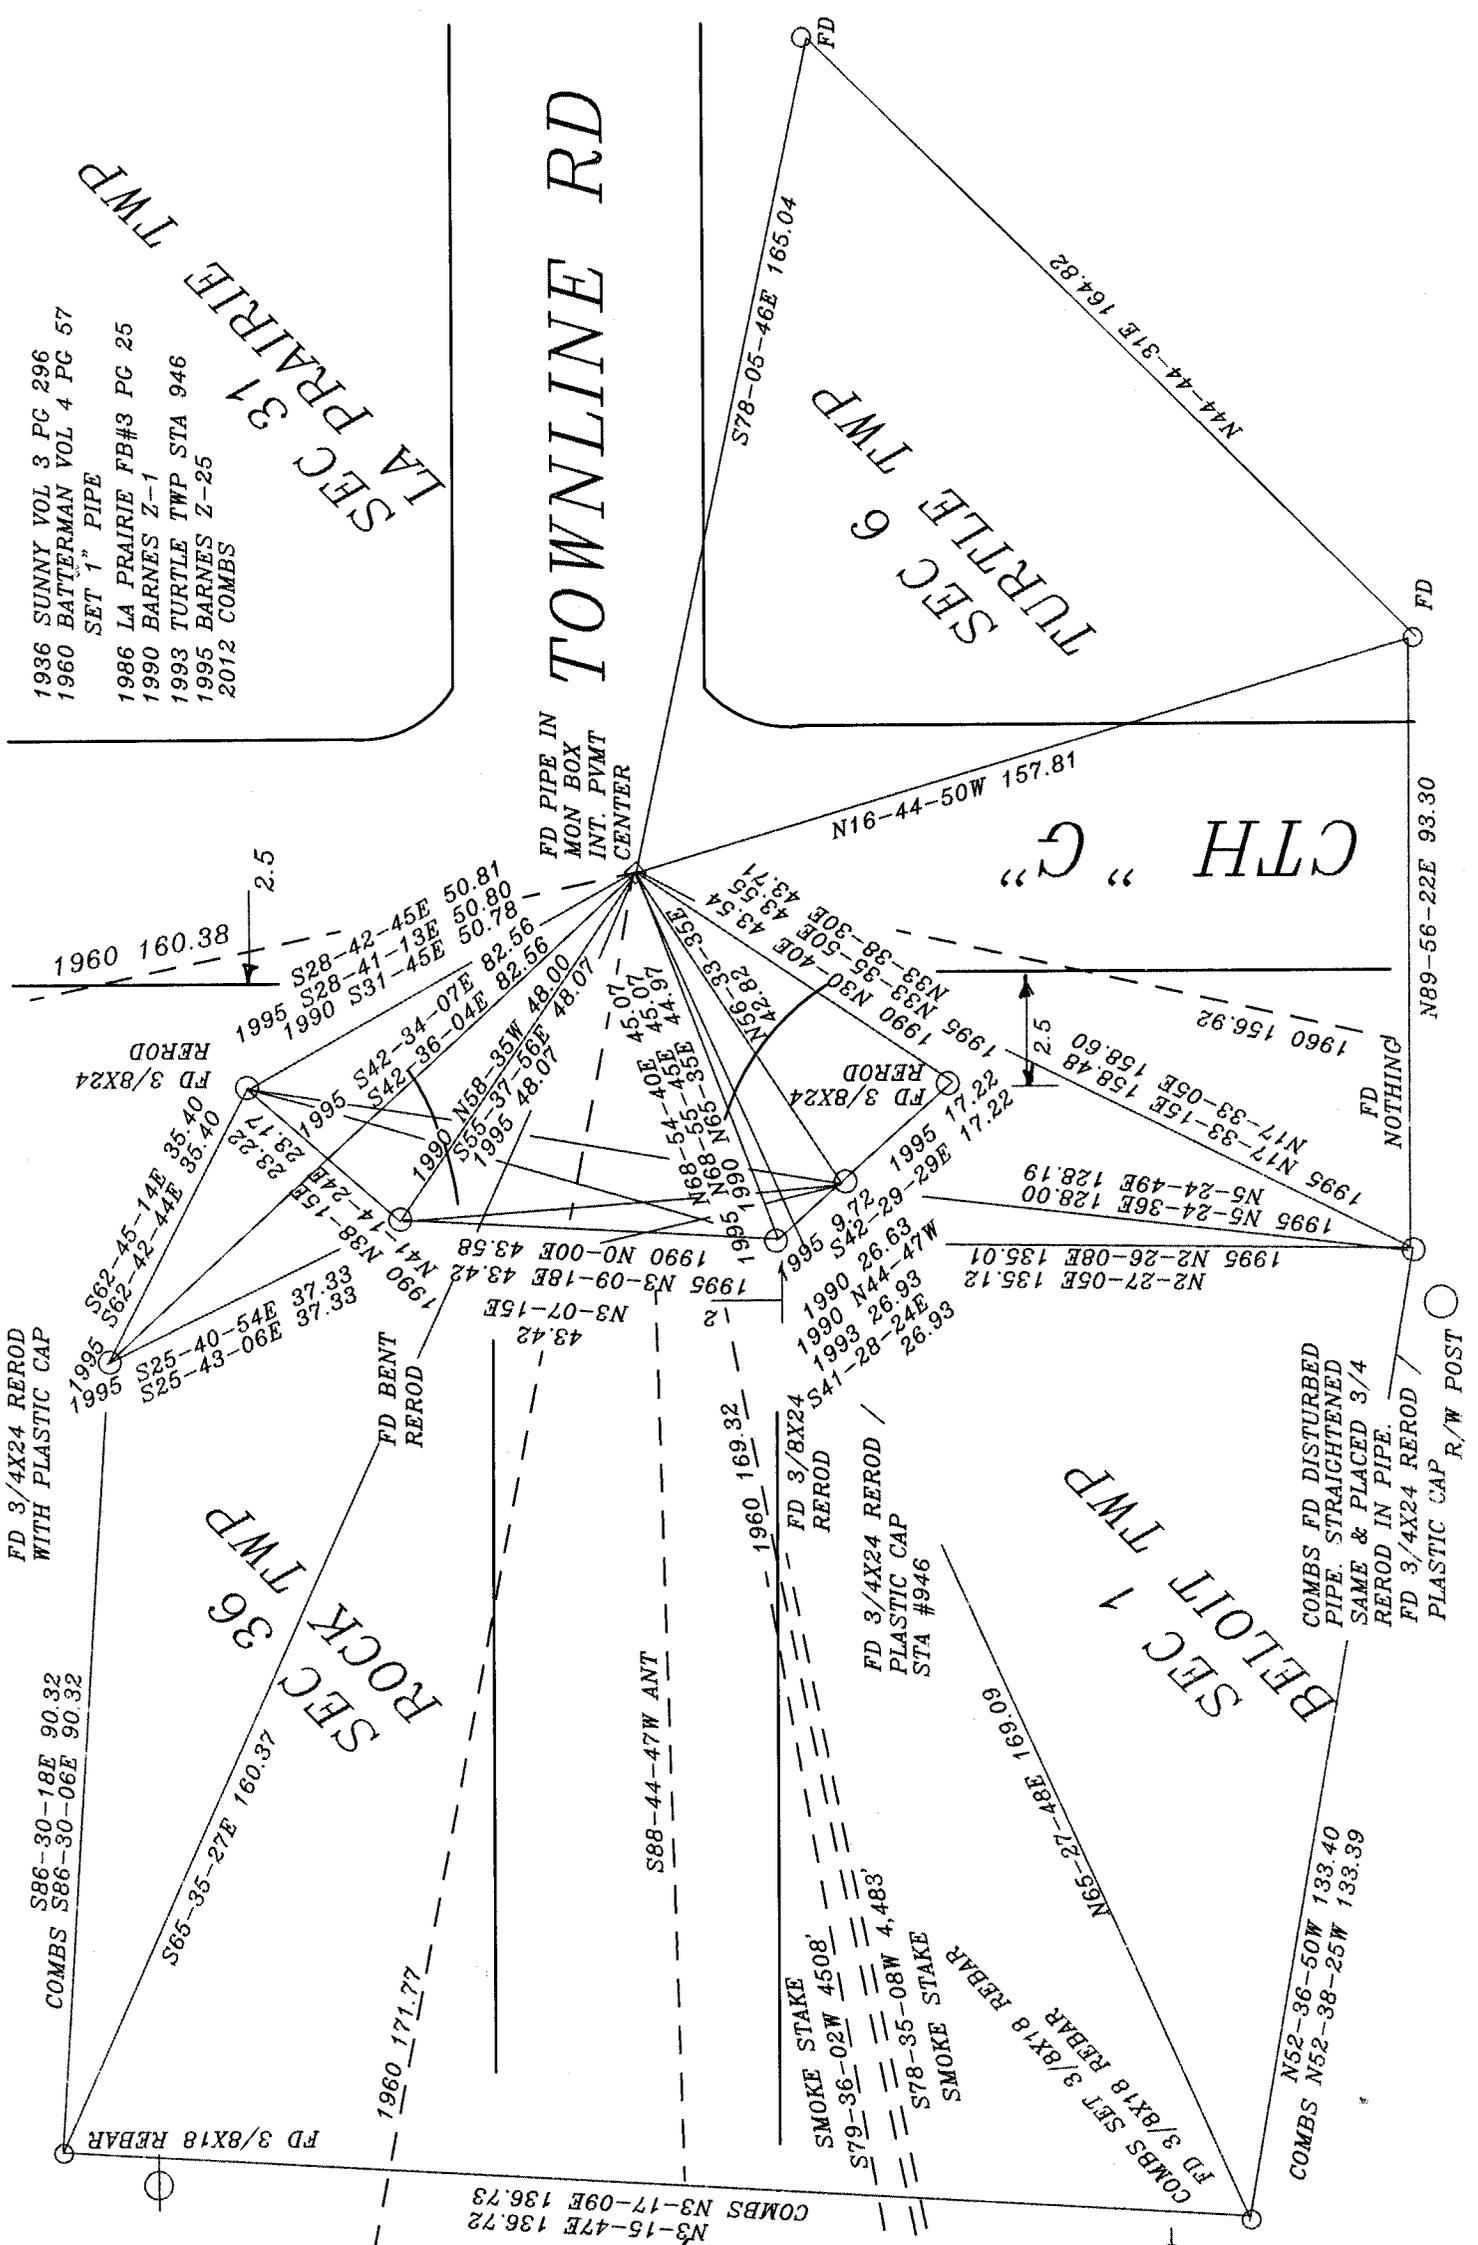

SEARCHED & FD NOTHING IN DITCH LINE

*David Barnes*  
 SEALS EMBOSSED  
 60919, 2012

SEARCHED & FD NOTHING IN DITCH LINE

SHEET 3 OF 3  
 A Z-25(i)

COMBS FD DISTURBED PIPE. STRAIGHTENED SAME & PLACED 3/4 REROD IN PIPE. FD 3/4X24 REROD PLASTIC CAP R/W POST

FD 3/4X24 REROD WITH PLASTIC CAP

ROCK TWP  
 SEC 36

BELOIT TWP  
 SEC 1

FD 3/4X24 REROD / PLASTIC CAP STA #946

SMOKE STAKE  
 S79-36-02W 4508'  
 S78-35-08W 4,483'  
 SMOKE STAKE

COMBS N52-36-50W 133.40  
 COMBS N52-38-25W 133.39

COMBS S86-30-18E 90.32  
 COMBS S86-30-06E 90.32

FD 3/BX18 REBAR

N3-15-47E 136.72  
 COMBS N3-17-09E 136.73

N65-27-48E 169.09

COMBS SET 3/BX18 REBAR  
 FD 3/BX18 REBAR

1960 160.38

FD 3/BX24 REROD

FD BENT REROD

FD 3/4X24 REROD WITH PLASTIC CAP

FD 3/BX24 REROD

2.5

2.5

FD PIPE IN MON BOX INT. PYMT CENTER

S78-05-46E 165.04

N44-44-31E 164.82

N16-44-50W 157.81

FD

N89-56-22E 93.30

FD NOTHING

FD

FD

